

MISSISSIPPI
BOARD OF WATER COMMISSIONERS
416 North State Street
Jackson, Mississippi 39201

CODED

WATER WELL DRILLERS LOG

Marshall
H 23
6-22-70

June 22 19 70 Bumpus Wells Marshall
date well completed firm name county well located

LANDOWNER:

R. C. Chestman
Warsaw, Miss
(mailing address)

description of formations encountered

from to

Clay
Sand

0 20
20 100

WELL LOCATION:

sec. 13 T. 3 N. R. 5 E.
1 1/2 miles West of Warsaw
(distance) (direction) (nearest town)

WELL PURPOSE: Drillers
(home, irrigation, municipal, industrial)

WELL COMPLETION DATA:

- (1) diameter (inches) 4"
- (2) total depth (feet) 100 feet
- (3) static water level (feet) 20 below top of ground.
- (4) casing PVC 100 feet
(material) (depth)

CODED

 If telescope see back.
(size)

- (5) screen 6 ft 9.4 feet
(length) (depth to top)
- 4" gravel wall
(size) (material)

- (6) pump 3/4 10
(HP) (yield gpm)

(type power)

- (7) electric log elect
(yes or no)

(organization running log)

- (8) how well bottom plugged 4" cap.


JUL 24 1970

DRILLERS REMARKS:

MISS. BD. OF
WATER

If well telescopes please sketch and show depths.

GROUND LEVEL

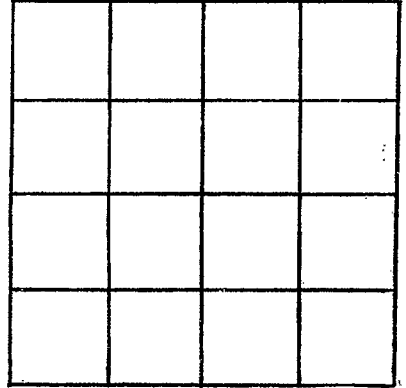

SECTION _____

Please indicate well location X.

ADDITIONAL INFORMATION

If more than one screen, show locations of each on sketch.