

MISSISSIPPI
BOARD OF WATER COMMISSIONERS
416 North State Street
Jackson, Mississippi 39201

CODED

WATER WELL DRILLERS LOG

Marshall
H 24
6-23-70

June 23 19 70 Bumper Wells Marshall
date well completed firm name county well located

LANDOWNER:

Joe Esten
Warsaw, Miss
(mailing address)

description of formations encountered

from

to

clay
sand

0 20
20 90

WELL LOCATION:

sec 13 T 3 N R 5 E
1 1/2 miles West of Warsaw
(distance) (direction) (nearest town)

WELL PURPOSE: Drinking
(home, irrigation, municipal, industrial)

WELL COMPLETION DATA:

- (1) diameter (inches) 4"
- (2) total depth (feet) 90 feet
- (3) static water level (feet) 30 below above top of ground.
- (4) casing PVC 90 feet
(material) (depth)
(size) If telescope see back.
- (5) screen 6 ft 84 feet
(length) (depth to top)
4" Gravel wall
(size) (material)
- (6) pump 3/4 10
(HP) (yield gpm)
(type power)
- (7) electric log Elect
(yes or no)

(organization running log)

(8) how well bottom plugged 4" cof.

CODED


JUL 24 1970

DRILLERS REMARKS:

MISS. RD. OF WATER

If well telescopes please sketch and show depths.

GROUND LEVEL

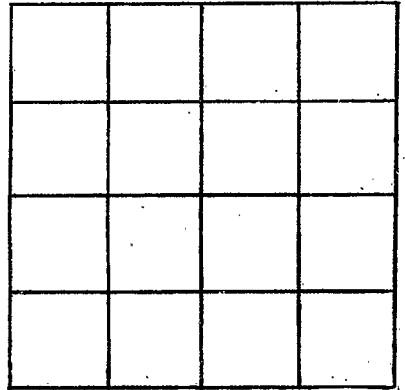

SECTION _____

Please indicate well location X.

ADDITIONAL INFORMATION

If more than one screen, show locations of each on sketch.