

MARSHALL
H 25
70

MISSISSIPPI
 BOARD OF WATER COMMISSIONERS
 416 North State Street
 Jackson, Mississippi 39201

CODED

WATER WELL DRILLERS LOG

Atkinson & Frost MARSHALL

date well completed _____ firm name _____ county well located _____

LANDOWNER: Christine

description of formations encountered

from to

Benson
Byhalia Miss
 (mailing address)

<u>Red SAND & CLAY</u>	<u>0</u>	<u>30</u>
<u>white SAND</u>	<u>30</u>	<u>90</u>
<u>CLAY</u>	<u>90</u>	<u>100</u>
<u>white SAND</u>	<u>100</u>	<u>120</u>

WELL LOCATION:

sec. 3 T. 3 N. R. 5 W.
1/4 miles W of Watson
 (distance) (direction) (nearest town)

WELL PURPOSE: home
 (home, irrigation, municipal, industrial)

WELL COMPLETION DATA:

- (1) diameter (inches) 4"
- (2) total depth (feet) 120
- (3) static water level (feet) 80 below top of ground.
- (4) casing P.V.C. 120
 (material) (depth)
- (size) if telescope see back.
- (5) screen 10PK 110'
 (length) (depth to top)
4" P.V.C. + SAND
 (size) (material)
- (6) pump 3/4 12
 (HP) (yield gpm)
elec.
 (type power)
- (7) electric log _____
 (yes or no)

 (organization running log)
- (8) how well bottom plugged cap.

CODED


OCT 13 1970

DRILLERS REMARKS:

MISS. BD. OF
 WATER COMM.

If well telescopes please sketch and show depths.

GROUND LEVEL

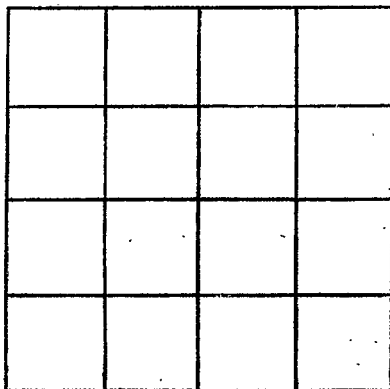

SECTION _____

Please indicate well location X.

ADDITIONAL INFORMATION

If more than one screen,
show locations of each on sketch.