

MARSHALL
 H 27
 73-71

MISSISSIPPI
 BOARD OF WATER COMMISSIONERS
 416 North State Street
 Jackson, Mississippi 39201

CODED

WATER WELL DRILLERS LOG

Atkinson & Frost *MARSHALL*

date well completed _____ 19 _____ firm name _____ county well located _____

LANDOWNER: *Willie N. Jeffers*
Byhalia Miss
 (mailing address)

description of formations encountered	from	to
Red <i>white</i> CLAY	0	10
<i>white</i> Y	10	90
<i>white</i> SAND	90	135

WELL LOCATION:
 sec. 3 T. 3 N. R. 5 E.
1 1/2 miles SW of Byhalia
 (distance) (direction) (nearest town)

WELL PURPOSE:
 (home, irrigation, municipal, industrial)

- WELL COMPLETION DATA:
- (1) diameter (inches) 4"
 - (2) total depth (feet) 135
 - (3) static water level (feet) 80 below top of ground.
 - (4) casing P.V.C. 125'
 (material) (depth)
 (size) if telescope see back.
 - (5) screen 10' 125'
 (length) (depth to top)
4" P.V.C.
 (size) (material)
 - (6) pump 3/4 10
 (HP) (yield gpm)
5/100
 (type power)
 - (7) electric log NO
 (yes or no)

CODED

(organization running log)

APP 5 1971


(8) how well bottom plugged CAP.

DRILLERS REMARKS:

MISS. BD. OF
 WATER COM.

If well telescopes please sketch and show depths.

GROUND LEVEL

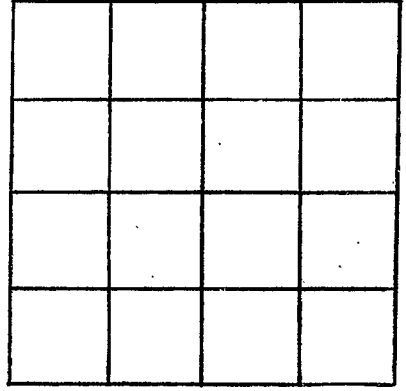

SECTION _____

Please indicate well location X.

ADDITIONAL INFORMATION

If more than one screen, show locations of each on sketch.