

MARSHALL
H28
5-3-71

MISSISSIPPI
 BOARD OF WATER COMMISSIONERS
 416 North State Street
 Jackson, Mississippi 39201

CODED

WATER WELL DRILLERS LOG

May 3 1971 Earl Jones Well Co. Marshall
 date well completed firm name county well located

LANDOWNER:
Andrew Warhurst
Byhalia Miss. RT.
 (mailing address)

description of formations encountered	depth	
	from	to
<u>Topsoil + clay</u>	<u>0</u>	<u>10</u>
<u>sand</u>	<u>10</u>	<u>25</u>
<u>sand + clay mixed</u>	<u>25</u>	<u>50</u>
<u>sand</u>	<u>60</u>	<u>95</u>
<u>clay</u>	<u>25</u>	<u>80</u>
<u>sand</u>	<u>80</u>	<u>112</u>

WELL LOCATION:
 sec 11 T 3 N R 5 E
2 1/4 miles S of Byhalia
 (distance) (direction) (nearest town)

WELL PURPOSE: Home
 (home, irrigation, municipal, industrial)

- WELL COMPLETION DATA:
- (1) diameter (inches) 2"
 - (2) total depth (feet) 112'
 - (3) static water level (feet) 60' below above top of ground.
 - (4) casing plastic 106'
 (material) (depth)
2"
 (size) if telescope see back.
 - (5) screen 6' 106'
 (length) (depth to top)
2" plastic - gravel
 (size) (material)
 - (6) pump 3/4 6
 (HP) (yield gpm).
Electric
 (type power)
 - (7) electric log no
 (yes or no)
 (organization running log)
 - (8) how well bottom plugged plastic cap.

CODED


JUN 2 1971

MISS. BD. OF
 WATER COMMISSIONERS

DRILLERS REMARKS:

If well telescopes please sketch and show depths.

GROUND LEVEL

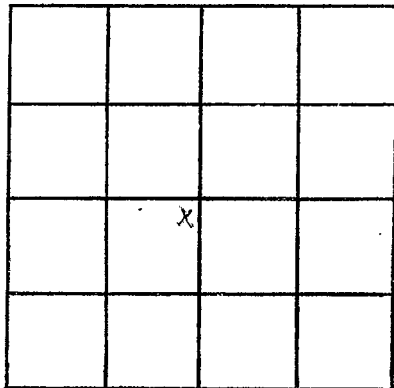

SECTION 11

Please indicate well location X.

ADDITIONAL INFORMATION

If more than one screen,
show locations of each on sketch.