


H 33  
7-25-63

WATER WELL DRILLERS LOG

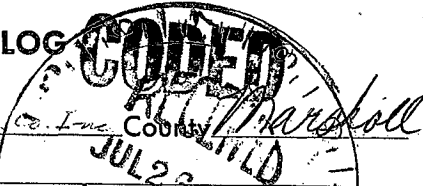

Date: 7-25, 1963, Driller: Adams Bros Co. Inc. County: Marshall  
(Name)

(1) Owner of Land: Eugene Hanna  
(Name)  
B. J. Hublin, Rte 2  
(Address)

(2) Location: 1/4, 26 3 5 Sec. 3 T. R  
\_\_\_\_\_ miles \_\_\_\_\_ of \_\_\_\_\_  
(distance) (direction) (Nearest Town)

(3) Topography: \_\_\_\_\_  
(Hilly) (Flat) (Level)

(4) Purpose of Well: \_\_\_\_\_  
(Domestic Irrigation, Municipal, Industrial, Other)

Description & Color of Materials Sand, Clay, Red Clay, Shell, etc.	Thickness Feet	Depth Feet
<u>top soil</u>	<u>0</u>	<u>20</u>
<u>red sand</u>	<u>20</u>	<u>40</u>
<u>white clay sand</u>	<u>40</u>	<u>100</u>
<u>good coarse sand</u>	<u>100</u>	<u>116</u>

Information upon completion of well:

(1) Diameter 4 inches.

(2) Total Depth 116 feet.

(3) Water Level 60 feet below top of ground.

(4) Cased to 109, Size \_\_\_\_\_

(5) Screen: Size 4", Length 7'

(6) Were any formations sealed against pollution?  
\_\_\_\_\_ yes, \_\_\_\_\_ no.

CODED

If YES depth of formation \_\_\_\_\_

Why \_\_\_\_\_

Drillers Remarks: \_\_\_\_\_

Well No.

(Use Back Side)

