

MARSHALL

CODED

WATER WELL DRILLERS LOG

H 34  
10-8-63

Date: 10-8, 1963, Driller: Albee of Independence County Marshall  
(Name)

(1) Owner of Land: C. L. Coley  
(Name)  
Byhalia Rte. 2  
(Address)

(2) Location: 10 35  
\_\_\_\_\_ miles \_\_\_\_\_ of \_\_\_\_\_  
(distance) (direction) (Nearest Town)

(3) Topography: \_\_\_\_\_  
(Hilly) (Flat) (Level)

(4) Purpose of Well: \_\_\_\_\_  
(Domestic Irrigation  
Municipal, Industrial, Other)

Description & Color of Materials Sand, Clay, Red Clay, Shell, etc.	Thick- ness Feet	Depth Feet
<u>Top soil</u>	<u>0</u>	<u>20</u>
<u>gravel</u>	<u>20</u>	<u>27</u>
<u>fine sand &amp; clay</u>	<u>27</u>	<u>115</u>
<u>good coarse sand</u>	<u>115</u>	<u>140</u>

Information upon completion of well:

(1) Diameter 4 inches.

(2) Total Depth 140 feet.

(3) Water Level 63 feet below top of ground.

(4) Cased to 133, Size \_\_\_\_\_


(5) Screen: Size 4", Length 7'

(6) Were any formations sealed against pollution?  
\_\_\_\_\_ yes, \_\_\_\_\_ no.

If YES depth of formation \_\_\_\_\_

Why \_\_\_\_\_

Drillers Remarks: \_\_\_\_\_

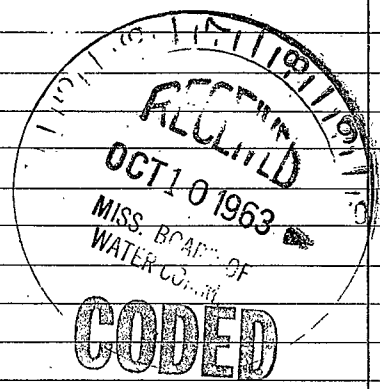

(Use Back Side)

Well No.

