

WATER WELL DRILLERS LOG

CODED

H36
4-14-64

Date: 4-14, 19 64, Driller: abc of 7 County: Marshall
(Name)

(1) Owner of Land: Roscoe Dix
(Name)
B yhalia
(Address)

(2) Location: 27 3 5
_____ 1/4, _____ 1/4, Sec. _____ T R
_____ miles _____ of _____
(distance) (direction) (Nearest Town)

(3) Topography: _____
(Hilly) (Flat) (Level)

(4) Purpose of Well: _____
(Domestic Irrigation
Municipal, Industrial, Other)

Description & Color of Materials Sand, Clay, Red Clay, Shell, etc.	Thick- ness Feet	Depth Feet
<u>top soil</u>	<u>0</u>	<u>20</u>
<u>red sand + little gravel</u>	<u>20</u>	<u>40</u>
<u>white fine sand</u>	<u>40</u>	<u>115</u>
<u>white coarse sand</u>	<u>115</u>	<u>125</u>

Information upon completion of well:

(1) Diameter 4 inches.

(2) Total Depth 125 feet.

(3) Water Level 55 feet below top of ground.

(4) Cased to 118, Size 4


(5) Screen: Size 4 " , Length 7 "

(6) Were any formations sealed against pollution?
_____ yes, _____ no.

CODED

If YES depth of formation _____
Why _____

Drillers Remarks: _____

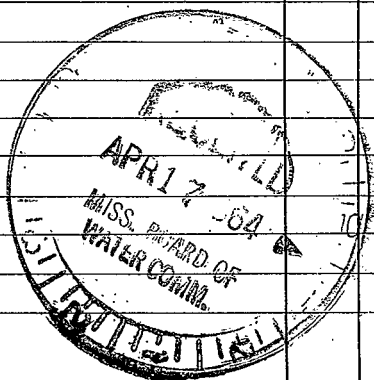

(Use Back Side)

Well No.

100

100

100