

MISSISSIPPI
BOARD OF WATER COMMISSIONERS
416 North State Street
Jackson, Mississippi 39201

CODED

WATER WELL DRILLERS LOG

Marshall
H39
5-67

May 1 1967 R. L. Carpenter Marshall
date well completed firm name county well located

LANDOWNER: Isaac Carter
Hwy 309
Byhalia Miss.
(mailing address)

WELL LOCATION:
sec 36 T-3 N R-5 E
1 1/2 miles East of Watson
(distance) (direction) (nearest town)


WELL PURPOSE: School
(home, irrigation, municipal, industrial)

WELL COMPLETION DATA:

- (1) diameter (inches) 4 in
- (2) total depth (feet) 130
- (3) static water level (feet) 70 below above top of ground.
- (4) casing Plastic 124 (material) (depth)
_____ if telescope see back.
(size)
- (5) screen 6 ft. 124 (length) (depth to top)
4 in. Plastic & Gravel (size) (material)
- (6) pump 1/2 12 (HP) (yield gpm)
Cleatase (type power)
- (7) electric log No (yes or no)
_____ (organization running log)
- (8) how well bottom plugged Plastic Plug

| description of formations encountered | from | to |
|---------------------------------------|------|-----|
| Surface Soil | 0 | 12 |
| Med. White sand | 12 | 41 |
| Med. white sand and Pink Clay | 41 | 65 |
| Med. white sand | 65 | 95 |
| White Clay | 95 | 111 |
| Coarse sand | 111 | 130 |

CODED

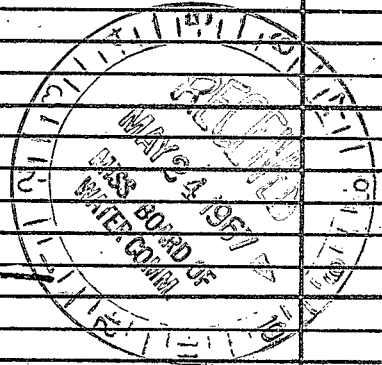


DRILLERS REMARKS:

If well telescopes please sketch and show depths.

GROUND LEVEL

R5W

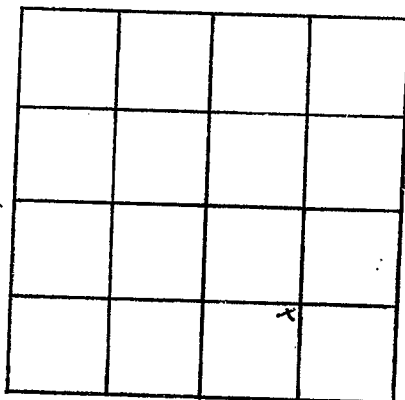

SECTION 36

Please indicate well location X.

ADDITIONAL INFORMATION

If more than one screen,
show locations of each on sketch.