

Marshall  
H 41  
J 2208

Atkinson & Frost

MISSISSIPPI  
BOARD OF WATER COMMISSIONERS  
416 North State Street  
Jackson, Mississippi 39201

**CODED**

WATER WELL DRILLERS LOG

7-27-1968  
date well completed

T. H. Austin  
firm name

Marshall  
county well located

LANDOWNER:

description of formations encountered	from	to
	Red clay	0
Red sand	15	40
White sand.	40	135

(mailing address)

WELL LOCATION:

sec. 3 T. 3 N. R. 4 E.  
K miles NE of Wesson  
(distance) (direction) (nearest town)

WELL PURPOSE:

(home, irrigation, municipal, industrial)

WELL COMPLETION DATA:

- (1) diameter (inches) 4 1/2
- (2) total depth (feet) 135
- (3) static water level (feet) 95 below top of ground.

- (4) casing (material) (depth) (size) if telescope see back.

- (5) screen 5 130 (length) (depth to top) (size) (material)


- (6) pump 1/2 10 (HP) (yield gpm) 230 (type power)

- (7) electric log (yes or no)

(organization running log)

- (8) how well bottom plugged

**CODED**

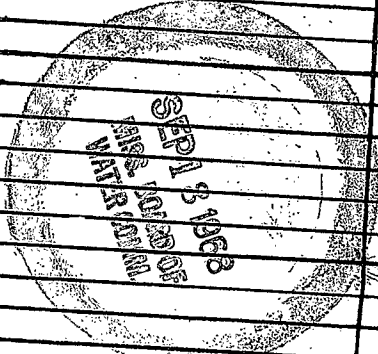


DRILLERS REMARKS:

Bob COSSARD

If well telescopes please sketch and show depths.

GROUND LEVEL

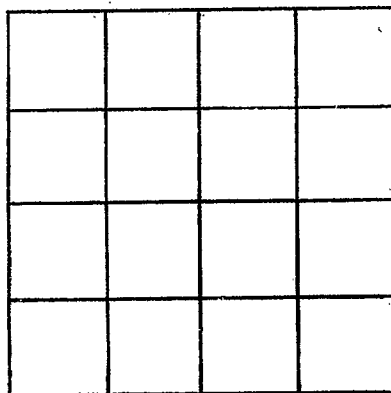

SECTION \_\_\_\_\_

Please indicate well location X.

ADDITIONAL INFORMATION

If more than one screen, show locations of each on sketch.