

Atkinson & Frost

MISSISSIPPI
BOARD OF WATER COMMISSIONERS

416 North State Street
Jackson, Mississippi 39201

CODED

WATER WELL DRILLERS LOG

Marshall
H42
7-24-68
7-24

1968 R. L. Lanning Wood

Marshall

date well completed

firm name

county well located

LANDOWNER:

description of formations encountered

from to

red clay	0	10
white clay	10	50
blue clay	50	90
rock	90	91
yellow sand	91	101
white clay	101	111
white sand	111	127

(mailing address)

WELL LOCATION:

sec. 3 T 3 N R 5 E
1 1/2 miles E of Bayalieu
(distance) (direction) (nearest town)


WELL PURPOSE:

(home, irrigation, municipal, industrial)

WELL COMPLETION DATA:

- (1) diameter (inches) 4"
- (2) total depth (feet) 137
- (3) static water level (feet) 90 below above top of ground:
- (4) casing (material) (depth) (size) If telescope-see back.
- (5) screen (length) (depth to top) (size) (material)
- (6) pump (HP) (yield gpm) 1 15
230 (type power)
- (7) electric log (yes or no) no
(organization running log)
- (8) how well bottom plugged

CODED

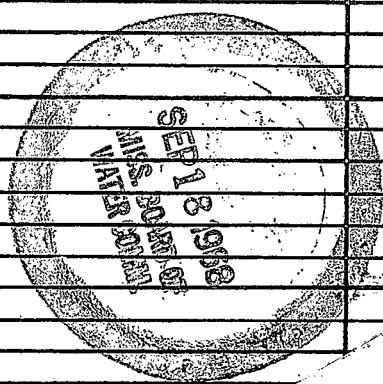


DRILLERS REMARKS:

Boe Co. S.S.A.

If well telescopes please sketch and show depths.

GROUND LEVEL

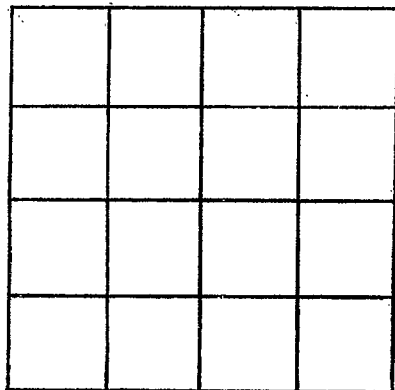

SECTION 3

Please indicate well location X.

ADDITIONAL INFORMATION

If more than one screen, show locations of each on sketch.