

MARSHALL

H 44

11-30-71

MISSISSIPPI BOARD OF WATER COMMISSIONERS
416 North State Street
Jackson, Mississippi 39201

DEC 17 1971

WATER WELL DRILLERS LOG

CODED

11-30

19 71 Deant Rest Bumpen

MARSHALL

date well completed

firm name

county well located

LANDOWNER:

J. P. Woods

Bjhalia Miss
(mailing address)

description of formations encountered

clay
sand

from

to

0

20

20

150

WELL-LOCATION:

sec. 36 T 3 N R 5 E
(S) (W)
1.3 miles west of Victoria
(distance) (direction) (nearest town)

WELL PURPOSE:

Drinking
(home, irrigation, municipal, industrial)

WELL COMPLETION DATA:


- (1) diameter (inches) 4"
- (2) total depth (feet) 150 feet
- (3) static water level (feet) 85 feet below top of ground.
- (4) casing PVC, 1.50 (depth)
(material) (size) If telescope see back.
- (5) screen 6 ft, 14 ft
(length) (depth to top)
4" ground wool
(size) (material)
- (6) pump 1 (HP), 18 (yield gpm)
(type power)
- (7) electric log ELF
(yes or no)
(organization running log)
- (8) how well bottom plugged 4" cap

CODED

DRILLERS REMARKS:

If well telescopes please sketch and show depths.

GROUND LEVEL

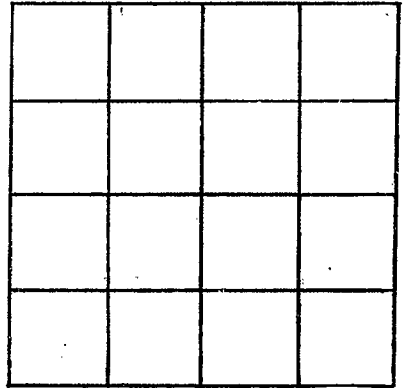

SECTION _____

Please indicate well location X.

ADDITIONAL INFORMATION

If more than one screen,
show locations of each on sketch.