

**CODED**

MISSISSIPPI  
BOARD OF WATER COMMISSIONERS FEB 28 1972  
416 North State Street  
Jackson, Mississippi 39201

MISS. D.  
WATER C.

**WATER WELL DRILLERS LOG**

**MARSHALL**  
**H45**  
**2-72**


19            date well completed      G. and H. Well Company firm name      Marshall county well located

| LANDOWNER:   | description of formations encountered | from | to                 |
|--|---------------------------------------|------|--------------------|
| Earnest Lee Perry  |                                       |      |                    |
| Route 2 Box 231A   | Red Clay                              | 1    | 15                 |
| Byhalia, Mississippi   | Red Sand                              | 15   | 25                 |
| (mailing address)  | Red Clay & Rock                       | 25   | 35                 |
| WELL LOCATION:   | Black Clay & Rock                     | 35   | 45                 |
| sec. <u>3</u> T <u>3</u> N R <u>5</u> E                            | Black & White Clay                    | 45   | 55                 |
| 2 miles NW of Byhalia  | White Clay                            | 55   | 65                 |
| (distance) (direction) (nearest town)                              | White Clay And Sand                   | 65   | 75                 |
| WELL PURPOSE: Home   | Sand & White Clay                     | 75   | 85                 |
| (home, irrigation, municipal, industrial)                          | Sand & White Clay                     | 85   | 95                 |
| WELL COMPLETION DATA:  | White Sand                            | 105  | <del>145</del> 145 |
| (1) diameter (inches) <u>4 IN</u>                                  | White Sand & Clay                     | 145  | 155                |
| (2) total depth (feet) <u>185</u>                                  | White Sand                            | 165  | 185                |
| (3) static water level (feet) <u>85</u> below above top of ground. |                                       |      |                    |
| (4) casing <u>Plastic</u> <u>185</u>                               |                                       |      |                    |
| (material) (depth)   |                                       |      |                    |
| <u>0</u> If telescope see back.                                    |                                       |      |                    |
| (size)   |                                       |      |                    |
| (5) screen <u>10 F.t.</u> <u>185</u>                               |                                       |      |                    |
| (length) (depth to top)  |                                       |      |                    |
| <u>4 in</u> <u>Slotted</u>   |                                       |      |                    |
| (size) (material)  |                                       |      |                    |
| (6) pump <u>3/4</u> <u>10 BPM</u>                                  |                                       |      |                    |
| (HP) (yield gpm)   |                                       |      |                    |
| <u>Electric 220</u>  |                                       |      |                    |
| (type power)   |                                       |      |                    |
| (7) electric log <u>No</u>   |                                       |      |                    |
| (yes or no)  |                                       |      |                    |
| (organization running log)   |                                       |      |                    |
| (8) how well bottom plugged <u>Cap</u>                             |                                       |      |                    |
| DRILLERS REMARKS:  |                                       |      |                    |

**CODED**

If well telescopes please sketch and show depths.

GROUND LEVEL

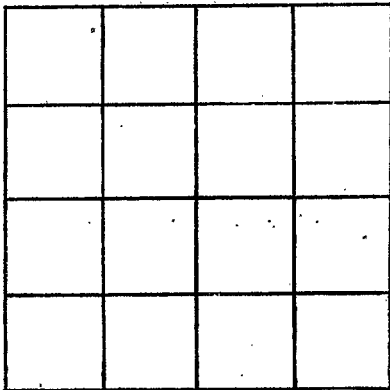

SECTION \_\_\_\_\_

Please indicate well location X.

ADDITIONAL INFORMATION

If more than one screen,  
show locations of each on sketch.