

MARSHALL
A 46
3-31-72

MISSISSIPPI
 BOARD OF WATER COMMISSIONERS
 416 North State Street
 Jackson, Mississippi 39201

CODED

WATER WELL DRILLERS LOG

3-31-1972 Dennis Hart Berger, Inc. Marshall
 date well completed firm name county well located


LANDOWNER:	description of formations encountered	from	to
<u>John B. Richardson</u>	<u>Clay</u>	<u>0</u>	<u>20</u>
<u>Bryhalia, Miss.</u> (mailing address)	<u>Sand mixed with gravel</u>	<u>20</u>	<u>90</u>
WELL LOCATION:			
sec. <u>12</u> T <u>3</u> N R <u>5</u> E (S) (W)			
<u>4</u> miles <u>south</u> of <u>Bryhalia</u> (distance) (direction) (nearest town)			
WELL PURPOSE: <u>Drinking</u> (home, irrigation, municipal, industrial)			
WELL COMPLETION DATA:			
(1) diameter (inches) <u>4"</u>			
(2) total depth (feet) <u>90 FT</u>			
(3) static water level (feet) <u>60 FT</u> ^{below} _{above} top of ground.			
(4) casing <u>PRC</u> , <u>90 ft.</u> (material) (depth)			
_____ (size) if telescope see back.			
(5) screen <u>6 FT.</u> <u>8 ft.</u> (length) (depth to top)			
<u>4"</u> <u>gravel wall</u> (size) (material)			
(6) pump <u>3/4</u> <u>10</u> (HP) (yield gpm)			
_____ (type power)			
(7) electric log <u>elect.</u> (yes or no)			
_____ (organization running log)			
(8) how well bottom plugged <u>4" cap.</u>			
DRILLERS REMARKS:			

CODED

APR 7 1972

If well telescopes please
sketch and show depths.

GROUND LEVEL

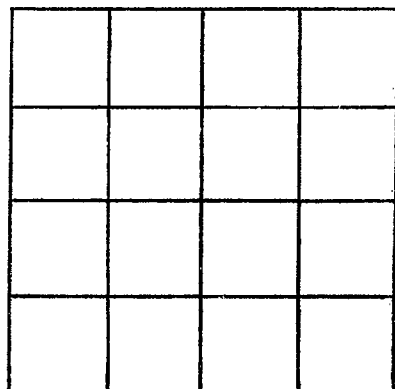

SECTION _____

Please indicate well location X.

ADDITIONAL INFORMATION

If more than one screen,
show locations of each on sketch.