

**MARSHALL**  
**H 47**  
**4-72**

MISSISSIPPI  
 BOARD OF WATER COMMISSIONERS  
 416 North State Street  
 Jackson, Mississippi 39201

WATER WELL DRILLERS LOG

**CODED**

*Atkinson & Frost*      *Marshall*

date well completed \_\_\_\_\_ firm name \_\_\_\_\_ county well located \_\_\_\_\_

LANDOWNER:  
*Janette Norman*  
*Bygalia Miss*  
 (mailing address)

description of formations encountered	from	to
<i>red clay</i>	<i>0</i>	<i>15</i>
<i>red sand</i>	<i>15</i>	<i>80</i>
<i>clay</i>	<i>80</i>	<i>85</i>
<i>white sand</i>	<i>85</i>	<i>120</i>

WELL LOCATION:  
 sec. 3 T. 3 N. R. 5 E.  
 (distance) (direction) (nearest town)  
2 miles S of Bygalia

WELL PURPOSE: home  
 (home, irrigation, municipal, industrial)

- WELL COMPLETION DATA:
- (1) diameter (inches) 4"
  - (2) total depth (feet) 120
  - (3) static water level (feet) 65 below top of ground.
  - (4) casing P.V.C. 110  
 (material) (depth)  
 (size) If telescope see back.
  - (5) screen 10 110  
 (length) (depth to top)  
4" P.V.C.  
 (size) (material)
  - (6) pump 3/4 10  
 (HP) (yield gpm)  
elec.  
 (type power)
  - (7) electric log \_\_\_\_\_  
 (yes or no)  
 \_\_\_\_\_  
 (organization running log)
  - (8) how well bottom plugged OK

**CODED**

**CODED**


APR 12 1972

MISS. Bd. OF WATER COMM.

DRILLERS REMARKS: \_\_\_\_\_

If well telescopes please sketch and show depths.

GROUND LEVEL

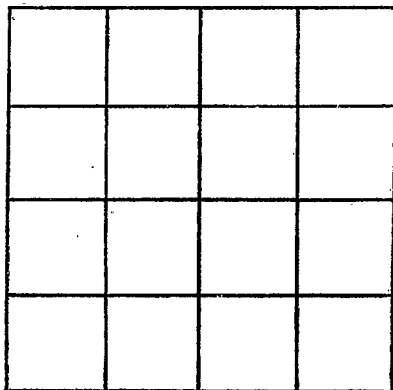

SECTION \_\_\_\_\_

Please indicate well location X.

ADDITIONAL INFORMATION

If more than one screen, show locations of each on sketch.