

**MARSHALL**  
**H 48**  
**4-6-72**

MISSISSIPPI  
 BOARD OF WATER COMMISSIONERS  
 416 North State Street  
 Jackson, Mississippi 39201

**CODED**

WATER WELL DRILLERS LOG

April 6 1972 *Walt Hansen & Son* *Marshall*  
 date well completed firm name county well located

LANDOWNER:  
*M. L. Rayford*  
*Bayfield Miss*  
 (mailing address)

description of formations encountered	from	to
<i>clay</i>	<i>0</i>	<i>15</i>
<i>yellow sand</i>	<i>15</i>	<i>90</i>

WELL LOCATION:  
 sec. 3 T. 3 N. R. 5 E  
 (S) (W)  
2 miles S of Marion  
 (distance) (direction) (nearest town)

WELL PURPOSE: Home  
 (home, irrigation, municipal, industrial)

- WELL COMPLETION DATA:
- (1) diameter (inches) 4"
  - (2) total depth (feet) 90'
  - (3) static water level (feet) 30 below above top of ground.
  - (4) casing P.V.C., 90  
 (material) (depth)  
 (size) If telescope see back.
  - (5) screen 5', 85'  
 (length) (depth to top)  
4", P.V.C.  
 (size) (material)
  - (6) pump 1/2, 10  
 (HP) (yield gpm)  
1/200  
 (type power)
  - (7) electric log NO  
 (yes or no)

**CODED**

APR 12 1972


(organization running log)  
 (8) how well bottom plugged CAP.

DRILLERS REMARKS:

MISS. BD. OF  
 WATER

If well telescopes please sketch and show depths.

GROUND LEVEL

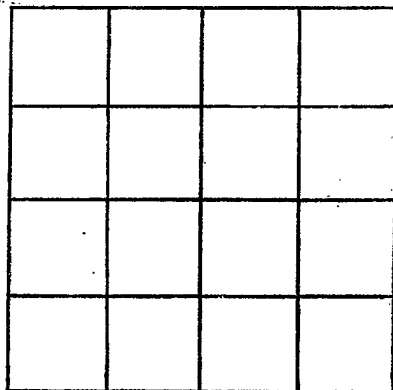

SECTION \_\_\_\_\_

Please indicate well location X.

ADDITIONAL INFORMATION

If more than one screen, show locations of each on sketch.