

MARSHALL
H 49
4-15-72

MISSISSIPPI
 BOARD OF WATER COMMISSIONERS
 416 North State Street
 Jackson, Mississippi 39201

CODED

WATER WELL DRILLERS LOG

April 15 1972 date well completed
 Earl Jones Well Co. firm name
 Marshall county well located

LANDOWNER:
 Victor H Jones
 Bylonia Miss
 (mailing address)

description of formations encountered	from	to
Topsoil & clay	0	12
Gravel	12	14
sand	14	24

WELL LOCATION:
 sec. 11 T. 3 N R. 5 E
 1 3/4 miles SW. of Bylonia
 (distance) (direction) (nearest town)

WELL PURPOSE: Home
 (home, irrigation, municipal, industrial)

- WELL COMPLETION DATA:**
- (1) diameter (inches) 4
 - (2) total depth (feet) 84
 - (3) static water level (feet) 30 below top of ground.
 - (4) casing plastic 78'
 (material) (depth)
4" if telescope see back.
 (size)
 - (5) screen 6' 78'
 (length) (depth to top)
4" plastic gravel
 (size) (material)
 - (6) pump 3/4 20
 (HP) (yield.gpm)
Electric
 (type power)
 - (7) electric log no
 (yes or no)
- (organization running log)
- (8) how well bottom plugged
plastic cap

CODED


APR 15 1972

DRILLERS REMARKS:

MISS. BD. OF
 WATER CONTROL

If well telescopes please sketch and show depths.

GROUND LEVEL

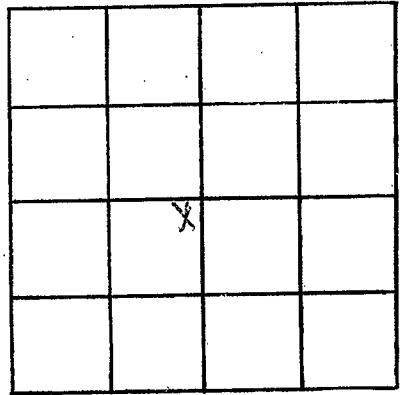

SECTION _____

Please indicate well location X.

ADDITIONAL INFORMATION

If more than one screen,
show locations of each on sketch.