

**MARSHALL**  
**H50**  
**6-12-72**

MISSISSIPPI  
 BOARD OF WATER COMMISSIONERS  
 416 North State Street  
 Jackson, Mississippi 39201

WATER WELL DRILLERS LOG

**CODED**

June 12 1972 Earl Jones Well Co Marshall  
 date well completed firm name county well located

LANDOWNER:  
Gene Shaleford  
Byhovia Miss. Rt.  
 (mailing address)

WELL LOCATION:  
 sec. 12 T. 3 N. R. 5 E  
2 miles S. of Byhovia  
 (distance) (direction) (nearest town)

description of formations encountered	from	to
Topsoil + clay	0	16
sand	16	25
Gravel + sand	25	45
clay	45	48
sand	48	152

WELL PURPOSE: Home + Tractor Pump  
 (home, irrigation, municipal, industrial)

WELL COMPLETION DATA:

(1) diameter (inches) 4

(2) total depth (feet) 152

(3) static water level (feet) 100 below top of ground.

(4) casing Plastic 1 1/2  
 (material) (depth)  
4" (size) if telescope see back.

(5) screen 6' 146  
 (length) (depth to top)  
4" plastic gravel  
 (size) (material)

(6) pump 1 1/2 30  
 (HP) (yield gpm)  
Electric  
 (type power)

(7) electric log no  
 (yes or no)

(organization running log)

**CODED**

JUL 13 1972


(8) how well bottom plugged  
plastic plug

DRILLERS REMARKS:

MISS. Bd. OF WATER COMM.

If well telescopes please sketch and show depths.

GROUND LEVEL

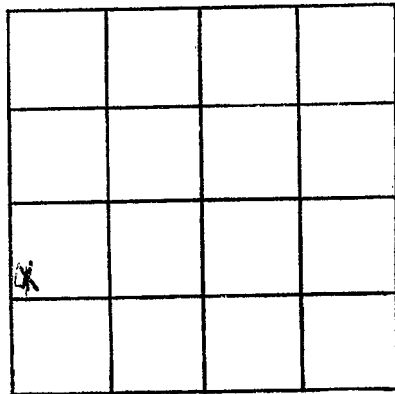

SECTION 12

Please indicate well location X.

ADDITIONAL INFORMATION

If more than one screen,  
show locations of each on sketch.