

MARSHALL
H 51
12-72

MISSISSIPPI
 BOARD OF WATER COMMISSIONERS
 416 North State Street
 Jackson, Mississippi 39201

CODED

WATER WELL DRILLERS LOG

date well completed 19 Atkinson & Frost firm name Marshall county well located

LANDOWNER: Tom Hasty
Byhalia Miss.
 (mailing address)

description of formations encountered	from	to
<u>clay</u>	<u>0</u>	<u>12</u>
<u>red sand</u>	<u>12</u>	<u>20</u>
<u>white sand</u>	<u>20</u>	<u>80</u>

WELL LOCATION:
 sec. 3 T. 3 N. R. 5 E
 (distance) miles (direction) of (nearest town)

WELL PURPOSE: None
 (home, irrigation, municipal, industrial)


- WELL COMPLETION DATA:
- (1) diameter (inches) 4"
 - (2) total depth (feet) 80
 - (3) static water level (feet) 40 below above top of ground.
 - (4) casing P.V.C. 80
 (material) (depth)
 - (size) If telescope see back.
 - (5) screen 5' 75'
 (length) (depth to top)
 - 4" P.V.C.
 (size) (material)
 - (6) pump 1/2 12
 (HP) (yield gpm)
 - elec.
 (type power)
 - (7) electric log (yes or no)
 - (organization running log)
 - (8) how well bottom plugged CAP.

DRILLERS REMARKS:

JAN 11 1973
 JAN 11 1973

If well telescopes please sketch and show depths.

GROUND LEVEL

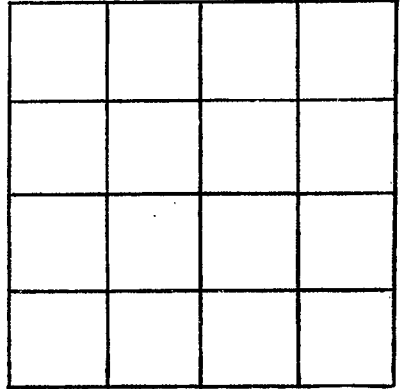

SECTION _____

Please indicate well location X.

ADDITIONAL INFORMATION

If more than one screen, show locations of each on sketch.