

MARSHALL
H52
12-18-72

MISSISSIPPI
 BOARD OF WATER COMMISSIONERS
 416 North State Street
 Jackson, Mississippi 39201

CODED

WATER WELL DRILLERS LOG

12-18 1972 *Atkinson & Frost* **MARSHALL**
 date well completed firm name county well located

LANDOWNER:
SAM Clowers
Byhalia Miss
 (mailing address)

description of formations encountered	from	to
<i>Clay & gravel</i>	<i>0</i>	<i>30</i>
<i>Brown sand</i>	<i>30</i>	<i>80</i>
<i>White sand</i>	<i>80</i>	<i>100</i>
<i>White clay</i>	<i>100</i>	<i>110</i>
<i>White sand</i>	<i>110</i>	<i>145</i>

WELL LOCATION:
 sec. 3 T. 3 N. R. 5 E.
4 1/2 miles E of Whisman
 (distance) (direction) (nearest town)

WELL PURPOSE:
 (home, irrigation, municipal, industrial)


- WELL COMPLETION DATA:
- (1) diameter (inches) 4 1/2
 - (2) total depth (feet) 145
 - (3) static water level (feet) 100 below top of ground.
 - (4) casing PVC 135
 (material) (depth)
 (size) If telescope see back.
 - (5) screen 1 1/2 145
 (length) (depth to top)
 (size) (material)
 - (6) pump 1 7
 (HP) (yield gpm)
Electric
 (type power)
 - (7) electric log (yes or no)
 - (organization running log)
 - (8) how well bottom plugged CAP

DRILLERS REMARKS:

JAN 17 1973

If well telescopes please sketch and show depths.

GROUND LEVEL

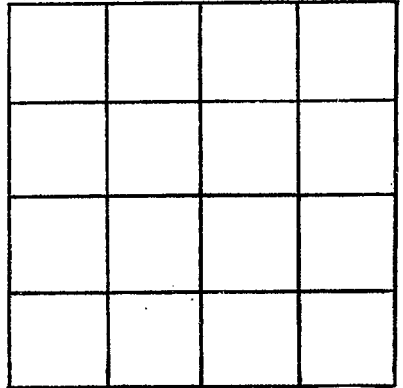

SECTION _____

Please indicate well location X.

ADDITIONAL INFORMATION

If more than one screen, show locations of each on sketch.