

MARSHALL

MISSISSIPPI
BOARD OF WATER COMMISSIONERS
416 North State Street
Jackson, Mississippi 39201

CODED
Marshall

~~DeSoto~~
H56
12-18-72

WATER WELL DRILLERS LOG

12-18-1972 date well completed Bob Smith firm name county well located

LANDOWNER:

E. W. Harris

description of formations encountered

clay dirt

from

to

15

Leiburg, miss.
(mailing address)

white clay

15 27

WELL LOCATION:

sec. 1 T. 3 N. R. 5 E.
2 1/2 miles East of Lewisport
(distance) (direction) (nearest town)

white sand

27 112

WELL PURPOSE: Home
(home, irrigation, municipal, industrial)

WELL COMPLETION DATA:

- (1) diameter (inches) 4
- (2) total depth (feet) 112
- (3) static water level (feet) 27 below top of ground.
- (4) casing Plastic 112
(material) (depth)
- (size) If telescope see back.
- (5) screen 20 92
(length) (depth to top)
- (size) 1 Plastic
(material)
- (6) pump 1/2 10
(HP) (yield gpm)
- Elec
(type power)
- (7) electric log No
(yes or no)
- (organization running log)

CODED

(8) how well bottom plugged plugged


DRILLERS REMARKS:

FEB 28 1973

If well telescopes please sketch and show depths.

GROUND LEVEL

Large vertical rectangular area for sketching well details, extending from the ground level line down to the bottom of the page.

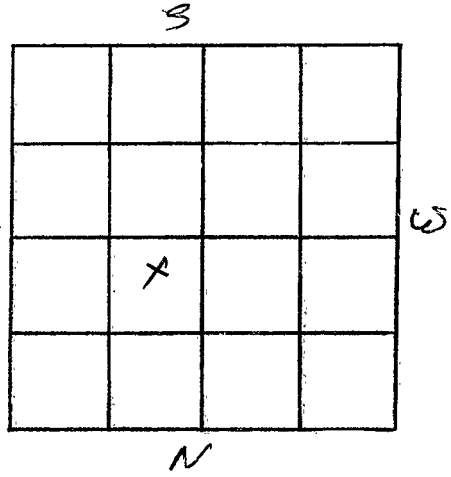

SECTION 1

Please indicate well location X.

ADDITIONAL INFORMATION

Lined area for providing additional information, consisting of approximately 20 horizontal lines.

If more than one screen, show locations of each on sketch.