

MARSHALL
H57
2-1-73

MISSISSIPPI
BOARD OF WATER COMMISSIONERS
416 North State Street
Jackson, Mississippi 39201

CODED

WATER WELL DRILLERS LOG

2-1 date well completed 1973 Harris Bros. firm name Marshall county well located

LANDOWNER: Alton Walls
2668 Durly Ct.
Memphis Tenn.
(mailing address)

| description of formations encountered | from | to |
|---------------------------------------|------|-----|
| top soil | 0 | 20 |
| pln gravel + sand | 20 | 55 |
| fine sand | 55 | 80 |
| clay + sand | 80 | 125 |
| coarse sand | 125 | 140 |

WELL LOCATION:
sec. 12 T. 3 N R. 5 E
cln Warsaw
(distance) (direction) (nearest town)

WELL PURPOSE: home
(home, irrigation, municipal, industrial)

- WELL COMPLETION DATA:
- (1) diameter (inches) 4
 - (2) total depth (feet) 140
 - (3) static water level (feet) 100 (below/above top of ground.)
 - (4) casing Plastic, 133
(material) (depth)
4 if telescope see back.
(size)
 - (5) screen 7, 133
(length) (depth to top)
008, Plastic
(size) (material)
 - (6) pump 3/4, 7
(HP) (yield gpm)
elec
(type power)
 - (7) electric log no
(yes or no)
 - (organization running log)
 - (8) how well bottom plugged solid


CODED

DRILLERS REMARKS:

MISS 36 4373

If well telescopes please sketch and show depths.

GROUND LEVEL

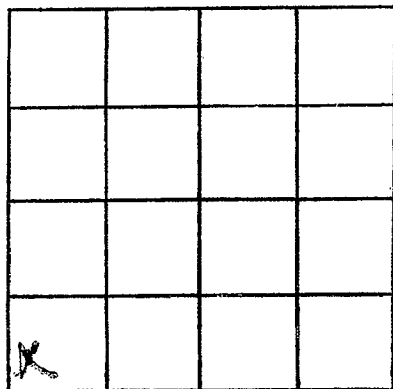

SECTION 12

Please indicate well location X.

ADDITIONAL INFORMATION

If more than one screen,
show locations of each on sketch.