

MISSISSIPPI
BOARD OF WATER COMMISSIONERS
416 North State Street
Jackson, Mississippi 39201

CODED

MARSHALL
H 58
9-12-72

WATER WELL DRILLERS LOG

9-12 1972 Harris Bros Marshall
date well completed firm name county well located

LANDOWNER Cardinal Machinery
3161 Tranquility Dr.
Memphis Tenn.
(mailing address)

description of formations encountered	from	to
<u>top soil</u>	<u>0</u>	<u>15</u>
<u>white clay</u>	<u>15</u>	<u>30</u>
<u>Clay + fine sand</u>	<u>30</u>	<u>105</u>
<u>Coarse sand</u>	<u>105</u>	<u>120</u>

WELL LOCATION:
sec. 10 T. 3 N. R. 5 E.
2 miles W of Warsaw
(distance) (direction) (nearest town)

WELL PURPOSE: none
(home, irrigation, municipal, industrial)

- WELL COMPLETION DATA:
- (1) diameter (inches) 4
 - (2) total depth (feet) 120
 - (3) static water level (feet) 60 below above top of ground.
 - (4) casing Plastic, 113
(material) (depth)
4 if telescope see back.
(size)
 - (5) screen 7, 113
(length) (depth to top)
008, Plastic
(size) (material)
 - (6) pump 3/4, 7
(HP) (yield gpm)
elec.
(type power)
 - (7) electric log no
(yes or no)
 - (organization running log)
 - (8) how well bottom plugged solid


CODED

DRILLERS REMARKS:

NOV 23 1972

If well telescopes please sketch and show depths.

GROUND LEVEL

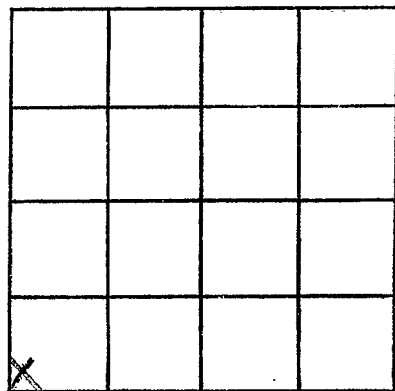

SECTION 10

Please indicate well location X.

ADDITIONAL INFORMATION

If more than one screen, show locations of each on sketch.