

MARSHALL

H 59

2-28-73

MISSISSIPPI BOARD OF WATER COMMISSIONERS
416 North State Street
Jackson, Mississippi 39201

WATER WELL DRILLERS LOG

CODED

Marshall

2-28-1973
date well completed

Bob Smith
firm name

Marshall
county well located

LANDOWNER:

Jimmie Mitchell

Watson - Miss.
(mailing address)

WELL LOCATION:

sec. 23 T. 3 N. R. 5 E.
1 1/2 miles North of WATSON
(distance) (direction) (nearest town)

WELL PURPOSE: Stone
(home, irrigation, municipal, industrial)

WELL COMPLETION DATA:

- (1) diameter (inches) 4
- (2) total depth (feet) 100
- (3) static water level (feet) 43 below top of ground.
- (4) casing Plastic 100 (material), (depth)
- (size) If telescope see back.
- (5) screen 20 80 (length), (depth to top)
- 4 Plastic (size), (material)
- (6) pump 1/2 10 (HP), (yield gpm)
- Electric (type power)
- (7) electric log no (yes or no)
- (organization running log)
- (8) how well bottom plugged plugged


description of formations encountered

description of formations encountered	from	to
clay dirt		8
yellow clay	8	16
Red clay	16	20
Red sand	20	25
gravel	25	35
Sand & gravel	35	45
white clay	45	60
white sand	60	100

DRILLERS REMARKS:

If well telescopes please sketch and show depths.

GROUND LEVEL

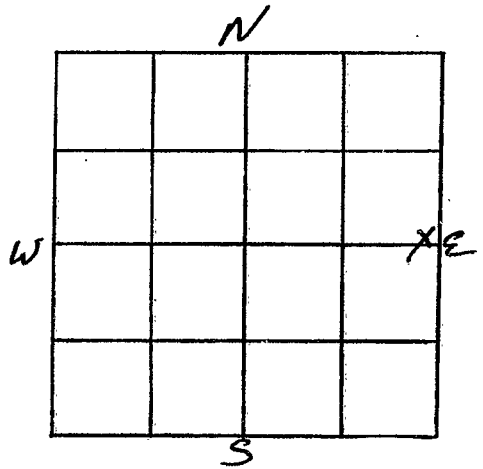

SECTION 23

Please indicate well location X.

ADDITIONAL INFORMATION

If more than one screen,
show locations of each on sketch.