

**H 60**  
**MARSHALL**  
**6-30-73**

MISSISSIPPI  
 BOARD OF WATER COMMISSIONERS  
 416 North State Street  
 Jackson, Mississippi 39201

**CODED**

**WATER WELL DRILLERS LOG**

June 30 1973 R. L. Casper Marshall  
 date well completed firm name county well located

LANDOWNER: Ethel Mitchell  
 Bayala, Miss.  
 RFD  
 (mailing address)

description of formations encountered	from	to
Surface Soil	0	14
Coarse Red Sand & Red clay	14	48
med. red sand	48	47
med. white sand	47	65
white coarse sand	65	80

WELL LOCATION:  
 sec. 25 T. 3 N. R. 5 E  
 1 miles north of Watson  
 (distance) (direction) (nearest town)

WELL PURPOSE: None  
 (home, irrigation, municipal, industrial)

WELL COMPLETION DATA:

(1) diameter (inches) 4

(2) total depth (feet) 90

(3) static water level (feet) 65 below top of ground.

(4) casing Plastic, 82 ft. (material) (depth)

(size) If telescope see back.

(5) screen 8 ft., 82 ft. (length) (depth to top)

4 in., Plastic lined (size) (material)

(6) pump 3/4 (HP) 10 (yield gpm)

Electric (type power)

(7) electric log no. (yes or no)

(organization running log)


(8) how well bottom plugged Plastic Cap

DRILLERS REMARKS:

AUG 17 1973

If well telescopes please sketch and show depths.

GROUND LEVEL

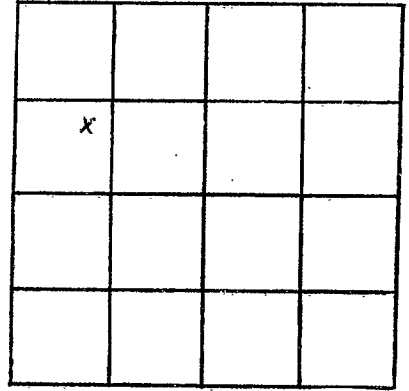

SECTION 25

Please indicate well location X.

ADDITIONAL INFORMATION

If more than one screen,  
show locations of each on sketch.