

**MISSISSIPPI
BOARD OF WATER COMMISSIONERS**
416 North State Street
Jackson, Mississippi 39201

WATER WELL DRILLERS LOG

MARSHALL
H 62
8-2-73

CODED

8-2-1973 Bob Smith Marshall
date well completed firm name county well located

LANDOWNER:	description of formations encountered	from	to
		To	6
Lester Beckford	clay fert		
Bethel - miss (mailing address)	Red clay	6	10
WELL LOCATION:	red sand	10	42
sec. 12 T 3 N R 5 E 1 1/2 miles SE of Bethel (distance) (direction) (nearest town)	white sand	42	80
WELL PURPOSE: None (home, irrigation, municipal, industrial)			
WELL COMPLETION DATA:			
(1) diameter (inches) 4			
(2) total depth (feet) 80			
(3) static water level (feet) 35 below above top of ground.			
(4) casing Plastic 80 (material) (depth)			
(size) If telescope see back.			
(5) screen 20 60 (length) (depth to top)			
4 Plastic (size) (material)			
(6) pump 1/2 10 (HP) (yield gpm)			
Elec (type power)			
(7) electric log no (yes or no)			
(organization running log)			
(8) how well bottom plugged plugged			
DRILLERS REMARKS:			


CODED

SEP 27 1973

MISS. BD. OF
WATER COMMISSIONERS

If well telescopes please sketch and show depths.

GROUND LEVEL

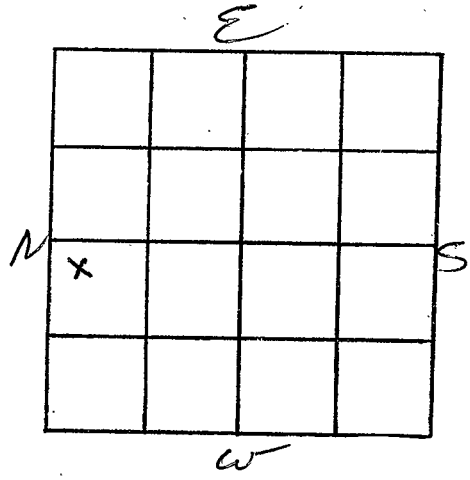

SECTION 12

Please indicate well location X.

ADDITIONAL INFORMATION

If more than one screen, show locations of each on sketch.