

MARSHALL

L-27 HLB

11-3-73

MISSISSIPPI BOARD OF WATER COMMISSIONERS
416 North State Street
Jackson, Mississippi 39201

CODED

WATER WELL DRILLERS LOG

Marshall

11-3-73
date well completed

Bob Smith
firm name

county well located

This location near sec 36 T3S R5W
see number

LANDOWNER:

Ross Rice

Watson, Miss.
(mailing address)

WELL LOCATION:

sec. 36 T3 N R 5 E
S W
1/4 miles east of Watson
(distance) (direction) (nearest town)

WELL PURPOSE: Home
(home, irrigation, municipal, industrial)

WELL COMPLETION DATA:

- (1) diameter (inches) 4
- (2) total depth (feet) 140
- (3) static water level (feet) 8' below top of ground.
- (4) casing Plastic 140'
(material) (depth)
- (size) if telescope see back.
- (5) screen 20' 120'
(length) (depth to top)
- 4' Plastic
(size) (material)
- (6) pump 1/2 10
(HP) (yield gpm)
- Elec.
(type power)
- (7) electric log No
(yes or no)
- (organization running log)

(8) how well bottom plugged
plugged

DRILLERS REMARKS:

description of formations encountered

from

to

top soil	0	5
red clay	5	15
white clay	15	25
white sand & clay	25	140

CODED

CODED


RECEIVED
MISSISSIPPI DEPARTMENT OF AGRICULTURE
JAN 15 1974

APR 8 1974

MISS. DEPT. OF AGRICULTURE

If well telescopes please sketch and show depths.

GROUND LEVEL

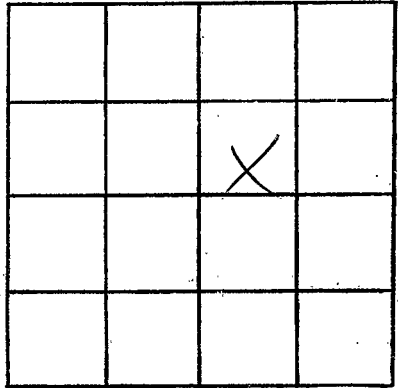

SECTION _____

Please indicate well location X.

ADDITIONAL INFORMATION

If more than one screen, show locations of each on sketch.