

MARSHALL
H 64
5-7-74

MISSISSIPPI
 BOARD OF WATER COMMISSIONERS
 416 North State Street
 Jackson, Mississippi 39201

CODED

WATER WELL DRILLERS LOG

5-7 date well completed 1974 Bob Smith & Son firm name Marshall county well located

LANDOWNER: <u>Percy Echols</u>	description of formations encountered	from	to
<u>Buhalia, Miss.</u> (mailing address)	<u>Red clay</u>	<u>5'</u>	<u>30'</u>
WELL LOCATION: sec. <u>36</u> T- <u>3</u> N R- <u>5</u> E <u>5</u> miles <u>SE</u> of <u>Watson</u> (distance) (direction) (nearest town)	<u>white sand</u>	<u>30'</u>	<u>140'</u>

CODED

WELL LOCATION:
 sec. 36 T-3 N R-5 E
5 miles SE of Watson
 (distance) (direction) (nearest town)

WELL PURPOSE: Home
 (home, irrigation, municipal, industrial)

- WELL COMPLETION DATA:**
- (1) diameter (inches) 4
 - (2) total depth (feet) 140'
 - (3) static water level (feet) 85 below top of ground.
 - (4) casing Plastic 140,
 (material) (depth)
 (size) if telescope see back.
 - (5) screen 10' 130
 (length) (depth to top)
4 Plastic
 (size) (material)
 - (6) pump 1/2 10
 (HP) (yield gpm)
Electric
 (type power)
 - (7) electric log no
 (yes or no)
 (organization running log)
 - (8) how well bottom plugged plugged

DEGENER


JUL - 5 1974

DRILLERS REMARKS:

MISS. BD. OF WATER COMM

If well telescopes please sketch and show depths.

GROUND LEVEL

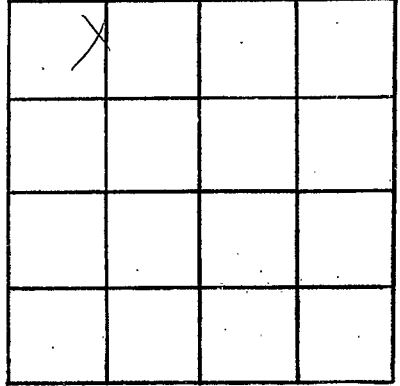

SECTION 36

Please indicate well location X.

ADDITIONAL INFORMATION

If more than one screen, show locations of each on sketch.