

MARSHALL
H65
7-1-74

MISSISSIPPI
BOARD OF WATER COMMISSIONERS
416 North State Street
Jackson, Mississippi 39201

CODED

WATER WELL DRILLERS LOG

7-1 date well completed 1974 DEAN HART BOMPAS well co. firm name Marshall county well located

LANDOWNER:	description of formations encountered	from	to
Joseph Pitt Byhalia, Miss. (mailing address)			

WELL LOCATION:
sec. 2 T. 3 N. R. 5 E
2 miles South of Byhalia
(distance) (direction) (nearest town)

gravel	10	30
sand	30	120

WELL PURPOSE: Drinking
(home, irrigation, municipal, industrial)

WELL COMPLETION DATA:

(1) diameter (inches) 4"

(2) total depth (feet) 120 feet

(3) static water level (feet) 65 feet below top of ground.

(4) casing PVC 120 feet (material) (depth)

(size) If telescope see back.

(5) screen 7 feet 113 feet (length) (depth to top)

4" gravel coat (size) (material)

(6) pump 3/4 HP 14 (yield/gpm)

(type power)

(7) electric log elect. (yes or no)

(organization running log)

(8) how well bottom plugged 4' cof.

CODE


RECORDED
AUG - 9 1974

MISS. BD. OF WATER COMM.

DRILLERS REMARKS:

If well telescopes please sketch and show depths.

GROUND LEVEL

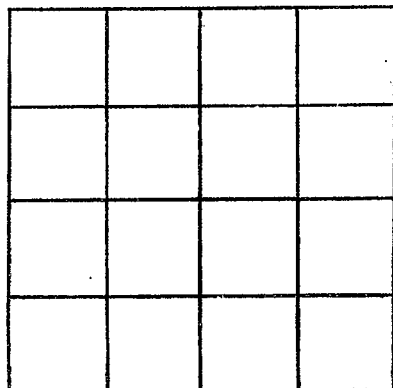

SECTION _____

Please indicate well location X.

ADDITIONAL INFORMATION

If more than one screen,
show locations of each on sketch.