

Marshall
H 67
5-24-75

MISSISSIPPI
BOARD OF WATER COMMISSIONERS
416 North State Street
Jackson, Mississippi 39201

WATER WELL DRILLERS LOG

CODED

5-24-75 date well completed
W.A. Mason Water Well Contractor firm name
Marshall county well located

LANDOWNER:
Robert H. Scarborough
RD, Byhalia Miss.
(mailing address)

description of formations encountered	from	to
Clay Silt	10	10
yellow clay	10	15
red clay	15	25
white sand	25	185

WELL LOCATION:
sec 36 T 3 N R 5 E 15E
2 miles S E of Watson
(distance) (direction) (nearest town)

WELL PURPOSE: Home
(home, irrigation, municipal, industrial)

- WELL COMPLETION DATA:
- (1) diameter (inches) 4 1/2"
 - (2) total depth (feet) 185'
 - (3) static water level (feet) 108' below top of ground.
 - (4) casing Plastic 175' (material) (depth)
4 1/2" (size) If telescope see back.
 - (5) screen 10' 175' (length) (depth to top)
4 1/2" Plastic (size) (material)
 - (6) pump 1 (HP) 10 (yield gpm)
electric (type power)
 - (7) electric log No (yes or no)
- (organization running log)

(8) how well bottom plugged
Cap on screen


DRILLERS REMARKS:

CODED

RECEIVED
JUL 01 1975

If well telescopes please sketch and show depths.

GROUND LEVEL

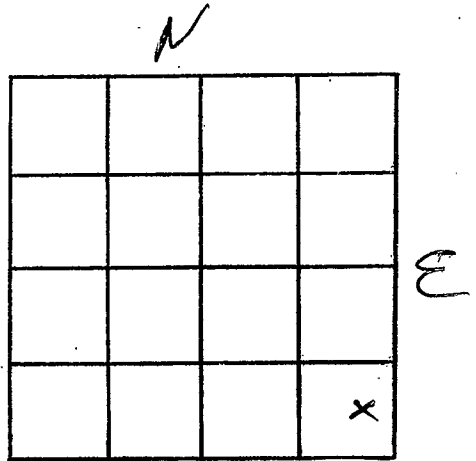

S
SECTION 36

Please indicate well location X.

ADDITIONAL INFORMATION

If more than one screen,
show locations of each on sketch.