

**MARSHALL**  
**H 69**  
**5-27-79**

MISSISSIPPI  
 BOARD OF WATER COMMISSIONERS  
 416 North State Street  
 Jackson, Mississippi 39201

CODED

WATER WELL DRILLERS LOG

5-27-1979 date well completed  
 W.A. Mason firm name  
 Marshall county well located

LANDOWNER:	description of formations encountered	from	to
Elmo Mitchell			
Attn. Byrdia Miss. (mailing address)	Red sand	12	30
WELL LOCATION:	Red clay	30	80
sec 36 T 3 N R 5 E 1/2 miles East of Watson (distance) (direction) (nearest town)	white sand	80	133
WELL PURPOSE: Home (home, irrigation, municipal, industrial)			
WELL COMPLETION DATA:			
(1) diameter (inches) 4"			
(2) total depth (feet) 133'			
(3) static water level (feet) 94' below top of ground.			
(4) casing Plastic, 123' (material) (depth)			
4" if telescope see back. (size)			
(5) screen 10' 123' (length) (depth to top)			
4" Plastic (size) (material)			
(6) pump 1/2 7 (HP) (yield gpm)			
electric (type power)			
(7) electric log No (yes or no)			
(organization running log)			
(8) how well bottom plugged Cap			
DRILLERS REMARKS:			

CODED


RECEIVED

DEC 27 1974

MISS. BD. OF WATER COMMISSIONERS

If well telescopes please sketch and show depths.

GROUND LEVEL

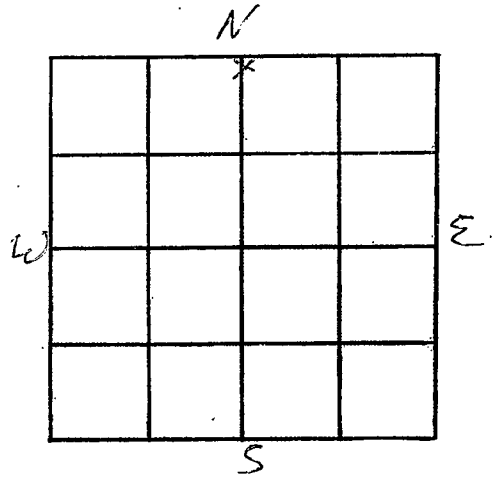

SECTION 36

Please indicate well location X.

ADDITIONAL INFORMATION

If more than one screen, show locations of each on sketch.