

MARSHALL
H 70
5-28-74

MISSISSIPPI
BOARD OF WATER COMMISSIONERS
416 North State Street
Jackson, Mississippi 39201

CODED

WATER WELL DRILLERS LOG

5-28-74 date well completed
W. R. Mason firm name
Marshall county well located

LANDOWNER:

D. Mitchell

description of formations encountered

Clay Soil

from

to

70

16

Rt. 3, Bynahalia Miss.
(mailing address)

Red sand

16

30

WELL LOCATION:

sec 36 T 3 N R 5 E
S W
1/2 miles East of Winton
(distance) (direction) (nearest town)

Red clay

30

85

WELL PURPOSE: Home
(home, irrigation, municipal, industrial)

white sand

85

144

WELL COMPLETION DATA:

CODED

- (1) diameter (inches) 4"
- (2) total depth (feet) 144'
- (3) static water level (feet) 106' below top of ground.
- (4) casing Plastic, 134' (material) (depth)
4" if telescope see back. (size)
- (5) screen 10' 134' (length) (depth to top)
4" Plastic (size) (material)
- (6) pump 3/4 7 (HP) (yield gpm)
electric (type power)
- (7) electric log No (yes or no)

(organization running log)

(8) how well bottom plugged Cap

RECEIVED


DEC 27 1974

DRILLERS REMARKS:

MISS. RD. OF WATER COMM.

If well telescopes please sketch and show depths.

GROUND LEVEL

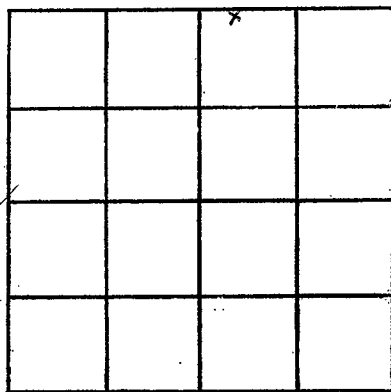

SECTION 36

Please indicate well location X.

ADDITIONAL INFORMATION

If more than one screen, show locations of each on sketch.