

MARSHALL
H 71
S-31-79

MISSISSIPPI
BOARD OF WATER COMMISSIONERS
416 North State Street
Jackson, Mississippi 39201

CODED

WATER WELL DRILLERS LOG

5-31-1974 date well completed
W.C. Mason firm name
Marshall county well located

LANDOWNER:	description of formations encountered	from	to
Joy W. Erwin			
Rt. 3, Byhalia Miss. (mailing address)	gravel	15	20
WELL LOCATION:	Red sand	20	40
sec. 36 T. 3 N. R. 5 E. (S) (W)	Red clay	40	90
1/2 miles East of Watson (distance) (direction) (nearest town)	White sand	90	144
WELL PURPOSE: None (home, irrigation, municipal, industrial)			
WELL COMPLETION DATA:			
(1) diameter (inches) 4"			
(2) total depth (feet) 144'			
(3) static water level (feet) 104' below top of ground.			
(4) casing Plastic 130' (material) (depth)			
4" if telescope see back. (size)			
(5) screen 14' 130' (length) (depth to top)			
4" Plastic (size) (material)			
(6) pump 3/4 7 (HP) (yield gpm)			
electric (type power)			
(7) electric log No (yes or no)			
(organization running log)			
(8) how well bottom plugged cap			
DRILLERS REMARKS:			


CODED

RECEIVED
DEC 27 1974

MISS. BD. OF WATER COMM

If well telescopes please sketch and show depths.

GROUND LEVEL

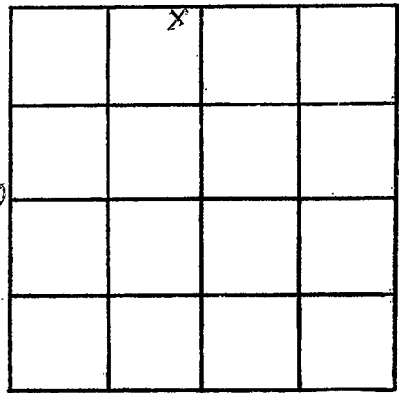

SECTION 36

Please indicate well location X.

ADDITIONAL INFORMATION

Lined area for additional information.

If more than one screen, show locations of each on sketch.