

MARSHALL
H 73
4-13-74

MISSISSIPPI
BOARD OF WATER COMMISSIONERS
416 North State Street
Jackson, Mississippi 39201

CODED

WATER WELL DRILLERS LOG

4-13-1974 date well completed
W.A. Mason firm name
Marshall county well located

LANDOWNER:	description of formations encountered	from	to
Watson Saddle Club P.O. Byhalia Miss. (mailing address)	clay bit	0	8
	pea gravel	8	20
WELL LOCATION: sec. 26 T-3 N R-5 E 1/4 miles West of Watson (distance) (direction) (nearest town)	Red clay	20	70
	white sand	70	90
WELL PURPOSE: <u>Club House</u> (home, irrigation, municipal, industrial)	blue clay	90	100
WELL COMPLETION DATA:	white sand	100	144
(1) diameter (inches) <u>4"</u>			
(2) total depth (feet) <u>144'</u>			
(3) static water level (feet) <u>63'</u> below top of ground.			
(4) casing <u>Plastic</u> , <u>124'</u> (material) (depth) <u>4"</u> (size) If telescope see back.			
(5) screen <u>20'</u> , <u>124'</u> (length) (depth to top) <u>4"</u> , <u>Plastic</u> (size) (material)			
(6) pump <u>1</u> , <u>15</u> (HP) (yield gpm) <u>electric</u> (type power)			
(7) electric log <u>No</u> (yes or no)			
(organization running log)			
(8) how well bottom plugged <u>cap</u>			
DRILLERS REMARKS:			


RECEIVED

DEC 27 1974

MISS. BD. OF WATER COMM

If well telescopes please sketch and show depths.

GROUND LEVEL

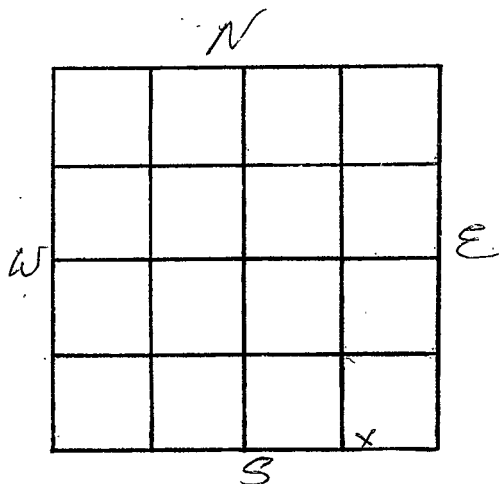

SECTION 76

Please indicate well location X.

ADDITIONAL INFORMATION

If more than one screen, show locations of each on sketch.