

MARSHALL
H75
4-5-74

MISSISSIPPI
BOARD OF WATER COMMISSIONERS
416 North State Street
Jackson, Mississippi 39201

CODED

WATER WELL DRILLERS LOG

4-5-1974 U.R. Mason Marshall
date well completed firm name county well located

LANDOWNER:
Beauty M. Sholar
Rt. Bynahia Miss.
(mailing address)

description of formations encountered	from	to
clay silt	0	4
Red clay	4	20
gravel	20	30
cherty sand	30	88

WELL LOCATION:
sec. 12 T. 3 N. R. 5 E.
S W
1/2 miles North of Winona
(distance) (direction) (nearest town)

WELL PURPOSE: Home
(home, irrigation, municipal, industrial)

WELL COMPLETION DATA:

(1) diameter (inches) 4"
(2) total depth (feet) 88'
(3) static water level (feet) 44' below top of ground.
(4) casing Plaster 78' (material) (depth)
4" (size) if telescope see back.
(5) screen 10' 78' (length) (depth to top)
4" (size) Plaster (material)
(6) pump 1/3 7 (HP) (yield gpm)
electrical (type power)
(7) electric log No (yes or no)
(organization running log)
(8) how well bottom plugged Cap

CODED


RECEIVED
DEC 27 1974

DRILLERS REMARKS:

MISS. BD. OF WATER COMM

If well telescopes please sketch and show depths.

GROUND LEVEL

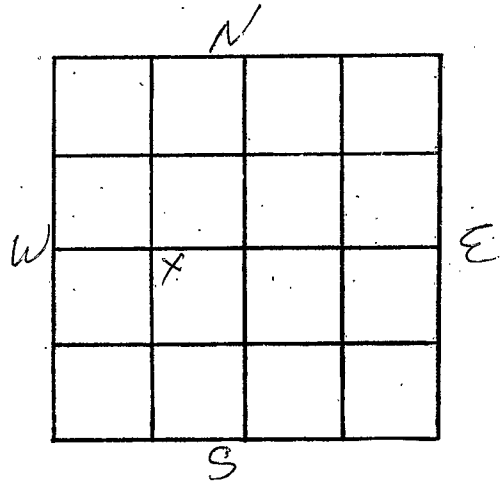

SECTION 12

Please indicate well location X.

ADDITIONAL INFORMATION

If more than one screen,
show locations of each on sketch.