

MISSISSIPPI DEPARTMENT OF NATURAL RESOURCES

Bureau of Land and Water Resources

Southport Mall

P.O. Box 10631

CODED

Jackson, Mississippi 39209

WATER WELL DRILLERS LOG

H-80
7-15-80
MARSHALL

7-15 1980 Nicks W. LLC Marshall  
 date well completed firm name county well located

LANDOWNER:  
Delbra' Priott  
Rt. 2, Bayhalia  
 (mailing address)

description of formations encountered	from	to
	<u>Clay</u>	<u>0</u>
<u>red sand</u>	<u>30</u>	<u>110</u>
<u>white sand</u>	<u>110</u>	<u>185</u>

WELL LOCATION:  
 sec. 27 T. 3 N. R 4 E  
2 1/2 miles W of Warren  
 (distance) (direction) (nearest town)

WELL PURPOSE: Home  
 (home, irrigation, municipal, industrial)

CODED

- WELL COMPLETION DATA:
- (1) diameter (inches) 4 in
  - (2) total depth (feet) 185
  - (3) static water level (feet) 100 below top of ground.
  - (4) casing Plastic 185  
 (material) (depth)
  - \_\_\_\_\_ If telescope see back.  
 (size)
  - (5) screen 2 ft 178  
 (length) (depth to top)  
4 in Gravel  
 (size) (material)
  - (6) pump 1/2 10  
 (HP) (yield gpm)  
220  
 (type power)
  - (7) electric log No  
 (yes or no)
  - \_\_\_\_\_ (organization running log)
  - (8) how well bottom plugged Cap

DRILLERS REMARKS:


DEPT. OF NATURAL RESOURCES  
 BUREAU OF LAND & WATER RESOURCES

SEP 4 - 1980

RECEIVED

If well telescopes please sketch and show depths.

GROUND LEVEL

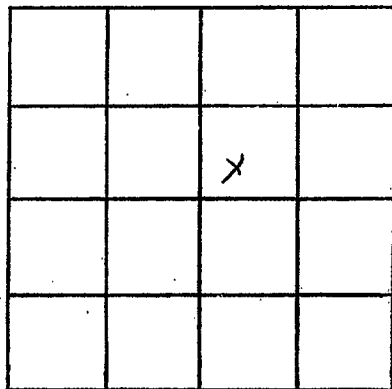

SECTION 27

Please indicate well location X.

ADDITIONAL INFORMATION

If more than one screen,  
show locations of each on sketch.