

MISSISSIPPI DEPARTMENT OF NATURAL RESOURCES

Bureau of Land and Water Resources

Southport Mall

P.O. Box 10631

CODED

Jackson, Mississippi 39209

WATER WELL DRILLERS LOG

MARSHALL
H 81
3-16-81

3-12 1981 Hicks Well Co. Marshall
date well completed firm name county well located

LANDOWNER: David Payne
P.O. Box 291
Byhalia, Mo.
(mailing address)


WELL LOCATION:
sec. 24 T 3 N R 5 E
3 miles NE of Watson
(distance) (direction) (nearest town)

WELL PURPOSE: Home
(home, irrigation, municipal, industrial)

WELL COMPLETION DATA:

- (1) diameter (inches) 4
- (2) total depth (feet) 135
- (3) static water level (feet) 90 below above top of ground.
- (4) casing PVC (material) (depth) _____
 if telescope see back.
(size)
- (5) screen 12 123
(length) (depth to top)
1/2" gravel & slotted
(size) (material)
- (6) pump 1/2 1.0
(HP) (yield gpm)
2200W
(type power)
- (7) electric log No.
(yes or no)
(organization running log) _____
- (8) how well bottom plugged Cap

description of formations encountered	from	to
Red Clay	0	10
Red Sand	10	50
White Clay	50	95
White Sand	95	135

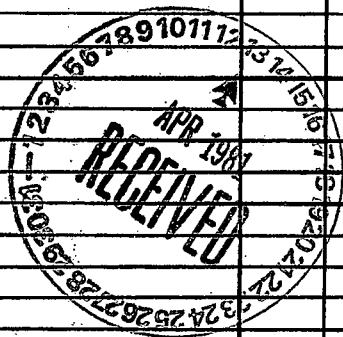

DEPT. OF NATURAL RESOURCES
BUREAU OF LAND & WATER RESOURCES


APR 13 1981

RECEIVED

DRILLERS REMARKS:

If well telescopes please sketch and show depths.

GROUND LEVEL

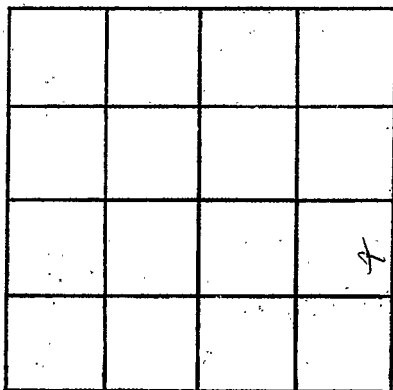

SECTION 24

Please indicate well location X.

ADDITIONAL INFORMATION

If more than one screen, show locations of each on sketch.