County: Marshall
Permit #:
Driller: Jones W. Mosar.
Date drilling completed: 3-29-05

•

.

Well Driller Report and Well Log

Mississippi Department of Environmental Quality Office of Land and Water Resources P.O. Box 10631 Jackson, MS 39289-0631 (601)961-5210 (601)354-6938 (fax)

For Office Use Only:				
Aquifer:				
Well #: H- 193				
L. S. Elevation:				
E-log #:				

State Law requires that this report be prepared by the driller in detail and filed with the Department within 30 days of completion of drilling of the well.

Well Owner Information	Well Location					
Owner Name Dickie Owens	Latitude: $34 \circ 50$, 117 "Longitude: $689 \circ 41$, 721 " 07 43					
Mailing Address: 387 Willview crl.	Method of Lat/Long (circle one): Conventional Survey,					
	USGS quad, I and-held GPS, Survey-grade GPS					
Byholia no 38611	NW14 SE 14 Sec 11 Twn 35 Rng 5w					
Byholia ns 38611 City State Zip Code						
Telephone No. (662) 835-3704	Distance Direction Nearest Town					
Well	Data					
Purpose of Well (circle one) (Home) Industrial Public Supply	y Irrigation Fish Culture Other:					
Date well drilling started: $3 - 29 - 05$ Date well drilling completed: $3 - 29 - 05$						
If flowing, method of flow regulation: Valve Other (describe)						
Static Water Level: <u>40</u> feet above or below (circle one) land surface Date measured: <u>3-39.05</u>						
Method of Measurement (circle one) steel tape electric tape air line other: <u>String (weight</u>						
Hole depth: Well depth: (10 Well grouted to a depth of feet						
Type of grout (circle one): Cement Bentonite M	lix					
Casing length: $1 \leq 0$ feet Casing diameter: -4 inches Type of casing: $-\rho \leq 0$						
Screen length: 10 feet Screen diameter: 4 inches Type of screen: 200						
Screen slot size: 010 inches Setting depth: From 100 feet to 100 feet						
Type of completion (circle all applicable): Gravel packed Underreamed Telescoped Open hole Natural Development						
Other (describe):						
Top of lap pipe or reduction in casing: \mathcal{N} feet. If telescoped or more than one screen, describe on back of page						
Logs run (circle all applicable): No log run Electric Gamma Ray Density Sonic Neutron Other:						
Name of organization running log(s):						
I certify that the well was drilled, constructed, and completed in accordance with all applicable requirements of the Mississippi Department of Environmental Quality and/or the Mississippi Department of Health regulations and state laws.						
Euri onnentai Quanty autior me mississippi Depat ment of ficatul regulations and state laws.						
Jares W. Mason O-620 Games. Mean						
Print Name of Water Well Contractor and License No.	Signature of Water Wall Construction/ [-])					
If well telescopes please sketch below and show depths.						

MAY 0 2 2005 BY: OLWR


Ground Level	.77- 193 Description of Formations Encountered	From	То
		0	130
	white soud	90	35
	while clay	35	40
	while soud	40	110
			+
			+
			+
			┥━━━
		2	
			1
			+
			+
			<u> </u>

A 1

If more than one screen, show location of each on sketch

.

4

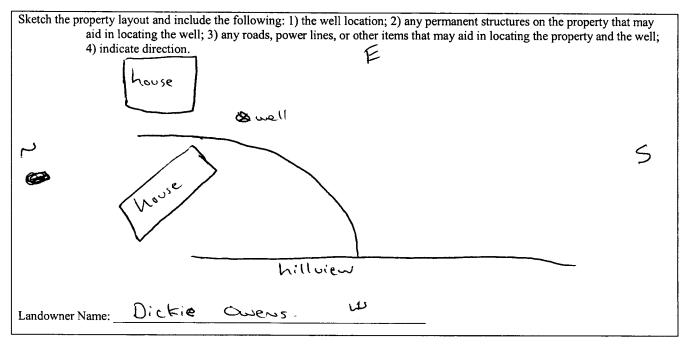

Signature of Water Well Contractor

RECEIVED MAY 0 2 2005 BY: OLWR

	STATE WF	LL REPORT			
County: MArsholl	Part 2		For Office Use Only:		
Permit #:		-	Aquifer:		
Driller: Jones w. Masa		t of Environmental Quality nd Water Resources	Well #: <u>H-193</u>		
Date completed: 3-29-05	P.O. B	ox 10631	Elevation:		
Date completed: 3-39-05 Jackson, MS 39289-0631 (601)961-5210 (601)961-5210					
(601)354-6938 (fax) This report must be prepared by the pump installer in detail and filed with the Department within 30 days of the					
installation of pum	p. A copy of Part 1 of this report mu	st be attached to this report	Location		
	ner Information				
	e Owens	Latitude: 34 50 117	$\underline{ \text{Longitude:}} \mathcal{OC9} \cdot \mathcal{U1} \cdot \mathcal{O21}$		
Mailing Address: <u>38</u>	hillview crl.	•	one): Conventional Survey,		
		USGS quad, Ha	nd-held GPS, Survey-grade GPS		
Byhal	State Zip Code	NW 1/ SE 1/4 Sec_	<u>11 Twn 35 Rng 5ω</u>		
City	State Zip Code	Distance Direction	Nearest Town		
Telephone No. (662) 83	38-3704	$\frac{(2 \text{ Miles } N W)}{N}$	of wersow		
		· · · · · · · · · · · · · · · · · · ·			
	ump Type Circle one		wer Type ircle one		
Air Lift J	et Submersible	Diesel Engine Gaso	line Engine Natural Gas		
Bucket F	Piston Turbine C	Electric Motor Han	d Tractor PTO		
Centrifugal F	Rotary Flowing Well		er (specify):		
Other (specify):		Horse Power Rating of Motor: 3/4			
Date Pump Installed:	3-29-05	Setting Depth: 80			
Rated Pump Capacity:	Gallons Per Minute	Number of Stages:	((
Pm	mp Test Data	Method of M	easuring Water Level		
-			Circle one		
Date Well Tested: $3 - 29 - 05$		Air Line Electric M	feasuring Line Steel Tape		
Static Water Level (A): <u>40</u> Feet Below Land Surface Pumping Water Level (B): <u>Feet Below Land Surface</u>		Other (specify): <u>Stris</u>	glweight		
			l shut in head: <u> パク</u> feet		
	Feet Below Land Surface	-			
	Gallons Per Minute		GPM with a drawdown of		
Duration of Pump Test (mi	nimum 4 hours): <u>24</u> hours	M feet afte	rhours of pumping		
I HEREBY CERTIFY that	the above statements are true to the be	est of my knowledge.			

Tores w. Mosor O-620 Print Name of Pump Installer and License No. (if applicable)

.

MAY 0.2 2035 BY: OLWR

RECEI

Signature of Pump Installer