County: MArshall
Permit #:
Driller: Jones w. Mason.
Date drilling completed: 3-30-05

Ý

-1

r

Well Driller Report and Well Log

Mississippi Department of Environmental Quality Office of Land and Water Resources P.O. Box 10631 Jackson, MS 39289-0631 (601)961-5210 (601)354-6938 (fax)

For Office Use Only:			
Aquifer:			
Well #: <u>H-195</u>			
L. S. Elevation:			
E-log #:			

BY: OLWR

State Law requires that this report be prepared by the driller in detail and filed with the Department within 30 days of completion of drilling of the well.

Well Owner Information	Well Location			
Owner Name Woody Woods.	Latitude: <u>34 • 49 · 132</u> " Longitude: 089 • 40 · 887 "			
Mailing Address: LOT 80	Latitude: $34 \cdot 49$, 132 , Longitude: $089 \cdot 40$, 887 , 9708 Method of Lat/Long (circle one): Conventional Survey,			
Moores plantation	USGS quad, Hand-held GPS, Survey-grade GPS			
N N	14 Nec 13 Twn 35 Rng 500			
City State Zip Code	SE SW Distance Direction Nearest Town			
Telephone No. (901) 487 - 5736	<u>12</u> Miles <u>S</u> of warsow			
Well	Data			
Purpose of Well (circle one Home Industrial Public Supply	y Irrigation Fish Culture Other:			
Date well drilling started: $3 \cdot 30 \cdot 05$ Date well drilling completed: $3 \cdot 30 - 05$				
If flowing, method of flow regulation: Valve $\sim A$ Other (describe)				
Static Water Level:feet above or below (circle one) land surface Date measured: 3-30-05				
Method of Measurement (circle one) steel tape electric tape air line other: String I weight				
Hole depth: <u>95</u> Well depth: <u>95</u> Well grouted to a depth of <u>(O</u> feet				
Type of grout (circle one): Cement Bentonite M	lix			
Casing length: 85 feet Casing diameter: 4	inches Type of casing: $\rho \circ c$			
Screen length: <u>(O</u> feet Screen diameter: <u>4</u>	inches Type of screen:			
Screen slot size: <u>O(0</u> inches Setting depth: From	n 85 feet to 95 feet			
Type of completion (circle all applicable): Gravel packed Underreamed Telescoped Open hole Natural Development				
Other (describe):				
Top of lap pipe or reduction in casing: $\mathcal{N}^{\mathcal{A}}$ feet. If telescoped or more than one screen, describe on back of page				
Logs run (circle all applicable): No log run Electric Gamma Ray Density Sonic Neutron Other:				
Name of organization running log(s):				
I certify that the well was drilled, constructed, and completed in accordance with all applicable requirements of the Mississippi Department of Environmental Quality and/or the Mississippi Department of Health regulations and state laws.				
Jones W. Mason 0-620	Jos w MADECENED			
Print Name of Water Well Contractor and License No.	Signature of Water Well Contractor			
If well telescopes please sketch below and show depths.	MAY 8 2 2505			


	H- 195 Description of Formations Encountered	H-195			
Ground Level	Description of Formations Encountered	From To			
	Cloy dirt.	0 30			
	while soud.	30 9			
1					

IJ

101

If more than one screen, show location of each on sketch

2.●

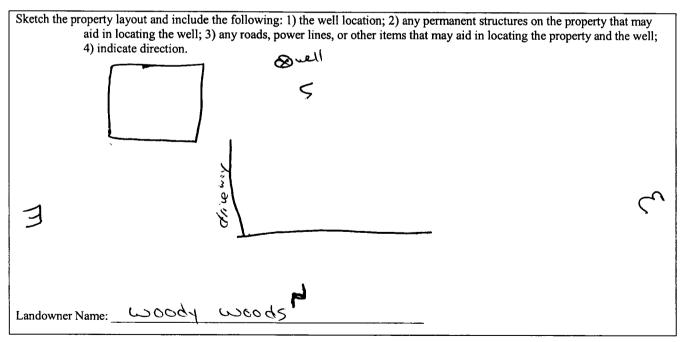

Signature of Water Well Contractor

RECEIVED MAY 0 2 2005 BY: OLW R

	STATE W	ELL REPORT				
	ך P	Part 2				
County: MACSUOU	Pump Installer's	s Completion Report	For Office Use Only: Aquifer:			
Permit #:	Mississippi Departmer	Mississippi Department of Environmental Quality				
Driller: Joes in Maser	Office of Land	and Water Resources	Well #: <u>H-195</u>			
Date completed: 3-30-05		P.O. Box 10631 Jackson, MS 39289-0631				
	(601)	(601)961-5210				
This report must be prepar	(601)35 red by the numn installer in	4-6938 (fax) detail and filed with the Dev	partment within 30 days of the			
installation of pump. A cop	y of Part 1 of this report m	ust be attached to this report	t.			
Well Owner Info			l Location			
Dwner Name: Woody Wo	200d5	Latitude: <u>34 · 49. 13</u> 5	Longitude: <u>087 · 40 · 887</u>			
Mailing Address: LOT 8	0	Method of Lat/Long (circle	one): Conventional Survey,			
	Plantation	USGS quad, Ha	Hand-held GPS, Survey-grade GPS			
Byhalio 1	VS 38611 State Zip Code	NW 1/4 NW 1/4 Sec	13 Twn 35 Rng 5w			
City	State Zip Code	Distance Direction	Nearest Town			
Telephone No. (901) 437 - 5	226	1/2 Miles 5				
Pump Ty	De	Por	wer Type			
Circle on			ircle one			
Air Lift Jet	Submersible	Diesel Engine Gaso	line Engine Natural Gas			
Bucket Piston	Turbine	Electric Motor Hand	d Tractor PTO			
Centrifugal Rotary	Flowing Well	Windmill Othe	r (specify):			
Dther (specify):		Horse Power Rating of Moto	or: <u>()</u>			
Date Pump Installed: <u>3 - 30 - 0</u>	05	Setting Depth:feet				
Rated Pump Capacity: (O	Gallons Per Minute	Number of Stages:	8			
Pump Test I	Data	Method of Me	asuring Water Level			
Date Well Tested: 3-30-0			rcle one			
tatic Water Level (A): $\partial 4$	Feet Below Land Surface	Air Line Electric Me	easuring Line Steel Tape			
Pumping Water Level (B):A		Other (specify): <u>String (weight</u>				
		For flowing well measured	shut in head: レム feet			
Vrawdown [(B) - (A)]; NA	Feet Below Land Surface		onat in noad. 79. t 1001			
Drawdown [(B) – (A)]: $\underline{\lor A}$ Test Pumping Rate: $\underline{(\lor)}$	Gallons Per Minute	Well yielded <u>()</u>	GPM with a drawdown of			
	Gallons Per Minute		GPM with a drawdown of			
Cest Pumping Rate: 10	Gallons Per Minute	Well yielded <u>()</u> <u>NA</u> feet after	GPM with a drawdown of			
Test Pumping Rate: (\)	Gallons Per Minute	Well yieldedfeet afterfeet afterfst of my knowledge.	GPM with a drawdown of			

e. . . .

BY: OLVUR