Permit #:	
	Mi
Driller: Jares $w \cdot Meser$ Date drilling completed: $4 \cdot 5 - c5$	

Well Driller Report and Well Log

Mississippi Department of Environmental Quality Office of Land and Water Resources P.O. Box 10631 Jackson, MS 39289-0631 (601)961-5210 (601)354-6938 (fax)


For Office Use Only:
Aquifer:
Well #: <u>H-200</u>
L. S. Elevation:
E-log #:

State Law requires that this report be prepared by the 30 days of completion of drilling of the well.	driller in detail and filed with the Department within
Well Owner Information	Well Location
Owner Name Homes Sweet Holmes	Latitude: 034 . 49 , 416 " Longitude: 089 . 40 , 651 " 25 39
Mailing Address: COT 105	Method of Lat/Long (circle one): Conventional Survey,
Moores plastation	USGS quad, (Hand-held GPS, Survey-grade GPS
Byholia Ms 32611	NE 1/4 NE 1/4 Sec 13 Twn 3.5 Rng Sw
City State Zip Code	Distance Direction Nearest Town
Telephone No. (901) 488 - 2297	<u>Ita</u> Miles <u>SE</u> of warsow
Well	l Data
Purpose of Well (circle one) Homo Industrial Public Suppl	y Irrigation Fish Culture Other:
Date well drilling started: <u>4-5-05</u> Da	
If flowing, method of flow regulation: Valve $\underline{\ } \mathcal{P} \underline{\ } \mathcal{R}$ Othe	er (describe)
Static Water Level: 54 feet above of below circle on	ne) land surface Date measured: 4 - 5 - 0 5
Method of Measurement (circle one) steel tape electric t	ape air line other: <u>String/weight</u>
Hole depth: <u>100</u> ′ Well depth: <u>100</u> ′	
Type of grout (circle one): Cement Bentonite M	ſix
Casing length: <u><u></u><u></u><u></u><u></u><u></u><u></u><u></u><u></u><u></u><u></u><u></u><u></u><u></u><u></u><u></u><u></u><u></u><u></u><u></u></u>	inches Type of casing: <u><u><u></u><u></u><u><u></u><u><u></u><u></u><u></u><u></u><u><u></u><u></u><u></u><u></u><u></u><u></u><u></u><u></u><u></u><u></u></u></u></u></u></u>
Screen length: <u>10</u> feet Screen diameter: <u>4</u>	
Screen slot size: , O(O inches Setting depth: From	•
Type of completion (circle all applicable): Gravel packed Un	nderreamed Telescoped Open hole Natural Development
Other (describe):	
Top of lap pipe or reduction in casing: $\underline{\mathcal{N}}^{\mathcal{A}}$ feet. I	If telescoped or more than one screen, describe on back of page
Logs run (circle all applicable) No log run Electric Gamma	Ray Density Sonic Neutron Other:
Name of organization running log(s): I certify that the well was drilled, constructed, and completed in accordance	with all applicable requirements of the Mississioni Department of
Environmental Quality and/or the Mississippi Department of Health regulat	
Jones W. Moson. 0-620	Gero w. Mos- Signature of Water Well Contractor
Print Name of Water Well Contractor and License No.	Signature of Water Well Contractor

If well telescopes please sketch below and show depths.

	H- 200		
Ground Level	Description of Formations Encountered		To
	Clay dirt.	0	15
	white Soud	15	40
	while clay	40	65
	while soud	67	(00
			-
			1
			1
			+
			+
			+
			<u> </u>
			†
			+

If more than one screen, show location of each on sketch

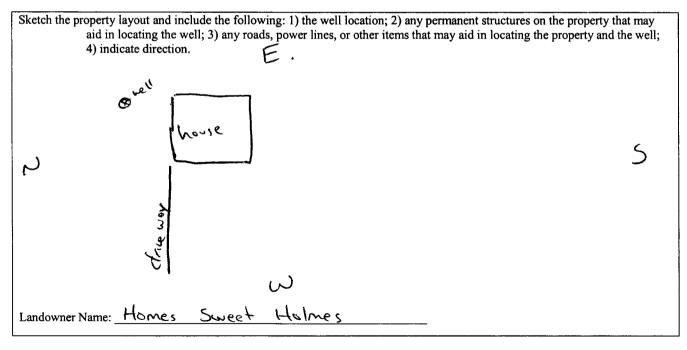

 \mathcal{N} Signature of Water Well Contractor

County: Morshell	STATE WELL REPORT Part 2 Pump Installer's Completion Report		For Office Use Only:	
Permit #: Driller: <u>Jones w. Mase</u> Date completed: <u>4-5-05</u>	Mississippi Department of Environmental Quality Office of Land and Water Resources P.O. Box 10631 Jackson, MS 39289-0631 (601)961-5210 (601)354-6938 (fax)		Aquifer: Well #: H200 Elevation:	
This report must be prepar	ed by the pump installer in wof Part 1 of this report my	detail and filed with the De	epartment within 30 days of the	
installation of pump. A copy of Part 1 of this report mu Well Owner Information		Well Location		
Owner Name: Homes Sure	et (tolmes	Latitude: <u>34.49,4</u>	416 Longitude: 089 · 40 · 65 1	
lailing Address: LOT 105		Method of Lat/Long (circle one): Conventional Survey,		
Moores plantation Byhalia Ms 38611 City State Zip Code		USGS quad, Hand-held GPS, Survey-grade GPS		
<u>Byhalia</u> City	Ms 38611 State Zip Code	$\frac{N \omega}{M} \frac{1}{M} \frac{N \omega}{M} \frac{1}{M} $		
Telephone No. (991) 488- 3	9997	n Nearest Town $_{\rm of} \underline{(x_{\rm o}, y_{\rm o}, y_$		
Pump Type Circle one			ower Type Circle one	
Air Lift Jet	Submersible	Diesel Engine Gas	oline Engine Natural Gas	
Bucket Piston	Turbine	Electric Motor Har	nd Tractor PTO	
Centrifugal Rotary	Flowing Well	Windmill Oth	ner (specify):	
Other (specify):		Horse Power Rating of Mo	otor: 314	
Date Pump Installed: 4-5-0	5	Setting Depth:	80 feet	
Rated Pump Capacity: \ Ə	Gallons Per Minute	Number of Stages:	1	
Pump Test Data			leasuring Water Level Circle one	
Date Well Tested: $4 - 5 - 05$ Static Water Level (A): 54 Feet Below Land Surface		Air Line Electric M Other (specify):	,	
Pumping Water Level (B): Pumping Water Level (B): Feet Below Land Surface				
Drawdown [(B) – (A)]: Feet Below Land Surface			For flowing well, measured shut in head: $\mathcal{N}^{\mathcal{A}}$ feet	
Test Pumping Rate:Gallons Per Minute		Well yielded GPM with a drawdown of		
Duration of Pump Test (minimum 4	hours): <u> つて</u> hours	$\underline{\mathcal{N}4}$ feet after	$r \rightarrow 4$ hours of pumping	
I HEREBY CERTIFY that the abov Thes . Marsu	e statements are true to the be	\sim	staller	

. 4