County: MArshall
Permit #:
Driller: Jones w. Moson
Date drilling completed: 5-4-05

Well Driller Report and Well Log

Mississippi Department of Environmental Quality
Office of Land and Water Resources
P.O. Box 10631
Jackson, MS 39289-0631
(601)961-5210
(601)354-6938 (fax)

For Office Use Only:	
Aquifer:	
Well #: H-205	
L. S. Elevation:	
E-log #:	


State Law requires that this report be prepared by the driller in detail and filed with the Department within 30 days of completion of drilling of the well

30 days of completion of drilling of the well.				
Well Owner Information	Well Location 22			
Owner Name Deshall Properties	Latitude: 34 . 48 , 105 Longitude: 089 . 43 ,497,			
Mailing Address: 510 wotson Desoto rd.	Method of Lat/Long (circle one): Conventional Survey,			
	USGS quad, Hand-held GPS, Survey-grade GPS			
Byholia Ms 38611 City State Zip Code	NW 1/4 NW 1/4 Sec 27 Twn 35 Rng Sw			
City State Zip Code				
Telephone No. (901) 491-0949	Distance Direction Nearest Town Miles of of otherwise			
Well	Data			
Purpose of Well (circle one) flome Industrial Public Supply	v Irrigation Fish Culture Other:			
Date well drilling started: 5-4-05 Da				
If flowing, method of flow regulation: Valve MA Othe	r (describe)			
Static Water Level:feet above of below tricle on	ne) land surface Date measured: 5 - 15-05			
Method of Measurement (circle one) steel tape electric ta	ape air line other: String luxeight.			
Hole depth: 95' Well depth: 95'	Well grouted to a depth of feet			
Type of grout (circle one): Cement Bentonite Mix				
Casing length: feet Casing diameter: inches Type of casing:				
Screen length: 10 feet Screen diameter: 1 inches Type of screen: pul				
Screen slot size:				
Type of completion (circle all applicable): Gravel packed Un	derreamed Telescoped Open hole Natural Development			
Other (describe):				
Top of lap pipe or reduction in casing:Afeet. If	f telescoped or more than one screen, describe on back of page			
Logs run (circle all applicable): No log run Electric Gamma R	ay Density Sonic Neutron Other:			
Name of organization running log(s): I certify that the well was drilled constructed and completed in accordance with the constructed and complete with the constructed and constructed and complete with the constructed and constructed and complete with the constructed and c	deb all amplicable and the second of the sec			
I certify that the well was drilled, constructed, and completed in accordance with all applicable requirements of the Mississippi Department of Environmental Quality and/or the Mississippi Department of Health regulations and state laws.				
Jones W. Moson 0-600	Jons w. Mosan			
Print Name of Water Well Contractor and License No.	Signature of Water Well Contractor			

H- 205

Ground Level	Description of Formations Encountered	From	To
	clay dirt.	0	G
	Grovel	6	30
	grovel	25	25
	while soud	25	95
			<u> </u>
·	**************************************		

If more than one screen, show location of each on sketch

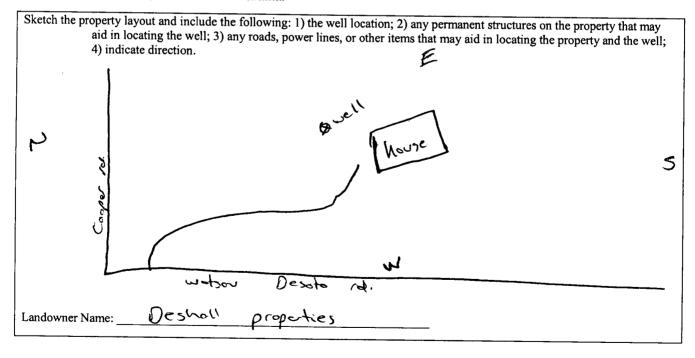

Signature of Water Well Contractor

BY. OLWA

STATE WELL REPORT Part 2

Pump Installer's Completion Report

County: MACShall Permit #:_

Mississippi Department of Environmental Quality Office of Land and Water Resources P.O. Box 10631

For Office Use Only: Aquifer:

Date completed:	-12-02	Jackson	, MS 39289-0631	Elevation:	
L)1)961-5210		
701. •		(601)	254 (020 (0.)		
I his repor	t must be prepare	d hy the numn installa-	21-4-11 × mx x x x	enartment with:	n 20 daya sest
			in detail and filed with the Domust be attached to this report	rt.	u 30 days of the
	Well Owner Intol	mation	We	ll Location	
Owner Name: A	eshall aca	perties	I		
The real real real real real real real rea	ST DIG	Derties_	Latitude: 34. 48. 107	ک Longitude: ۵	89.43.489
		son desate rd	I		
	0.0 (3 dt	202 QE3QF0 (9)	Method of Lat/Long (circle	one): Convention	onal Survey,
					•
1	ə .		USGS quad, Ha	ind-held GPS) Si	urvey-grade GPS
<u> </u>	2tholia M	rate Zip Code	NW 1/4 NW 1/4 Sec 2		
(City St	ate Zip Code	74 Sec_C	7 1wn_3	S Rng フい
		•	Distance Direction	Nearest T	•_
Telephone No. (90)	1 401		Brechon		
Telephone No. (90	171- 60	149	Miles Nu	of woter	。
					-
	D				
	Pump Type Circle one		Pov	wer Type	
	Circle one			ircle one	j
Air Lift	Jet	Submersible	D: 15		
		Quomersion	Diesel Engine Gasol	line Engine	Natural Gas
Bucket	Piston	Turbine	Electric Motor Hand		
		1 at office	Electric Motor Hand	l	Tractor PTO
Centrifugal	Rotary	Flowing Well	Windmill Other	- ([
Othon (on a sife)		•	J	r (specify):	
Other (specify):			Horse Power Rating of Moto	n. 3(J	
Date Pump Installed	. 6-15-	05			
		· · · · · · · · · · · · · · · · · · ·	Setting Depth:	50'	feet
Rated Pump Capacity	v: 12	Gallons Per Minute			
	/·	Ganons Per Minute	Number of Stages:1	(_
	Pump Test Data	1	N. 1. 1. 02.5		
	_			suring Water Lev	vel
Date Well Tested:	7-12-0	22	Cir	cle one	
Static Wat I I I I	. Ou		Air Line Electric Mes	asuring Line	G: 1 =
Static water Level (A	i):F	eet Below Land Surface			Steel Tape
			Other (specify): String	lucion+	ļ
r umping water Leve	Fe (B):Fe	et Below Land Surface	· · · · · - · · · · · · · · · · · · · ·	+	
Drawdown [(B) = (A)	al· 🔥 🗗 🖪	eet Below Land Surface			
(A)	1. 10/7 FE	Below Land Surface	For flowing well, measured sh	nut in head:	feet
Test Pumping Rate:	12	Gallons Per Minute			
_			Well yielded (2	GPM with a d	rawdown of
Duration of Pump Tes	st (minimum 4 hour	s): $\mathcal{A}_{\text{hours}}$	feet after	$\gamma_{i,i}$	i
		,nours	reet after	ho	urs of pumping
HEREDV CERTERY	7.41				
THEREDI CERTIFY	that the above state	ements are true to the bes	t of my knowledge.		
James 120	Masa		\sim		
rint Name of Pump I	nstaller and License	No Gen II	11/-m co-/1	00	
	LICENSE	(INO. (IT applicable)	Signoftume of D		1

	I HEREBY CERTIFY that the above statements are true to the	best of my knowledge.		
l	Print Name of Pump Installer and License No. (if applicable)	\bigcirc . \sim	Zeert j. dystra 1 to 1, green	35.5
				175