County: Morshall Part 1 - 1 Permit #:	State Well Report Part 1 – Driller's Log Mississippi Department of Environmental Quality Office of Land and Water Resources P.O. Box 10631 Jackson, MS 39289-0631 (601)961-5210 (601)354-6938 (fax)	
State Law requires that this report be prepared by the lia Department at the above address within 30 days of com Information on Well Owner (Landowner if borehole is not for a water well) Owner Name P-P- Builders- Mailing Address: 9318 - ST Poul rd. Buholia Ms 38611 City State Zip Code Telephone No. (101) 383 - 0897	<i>pletion of drilling of the well</i> Well or Bo Latitude: <u>34 • 49 • 851</u> Method of Lat/Long (circle or USGS quad, Hand-held	or borehole. orehole Location " Longitude: δ9 • 40 , 719 " " 43" ne): Conventional Survey, GPS) Survey-grade GPS Twn 35 Rng 5 Nearest Town
Well / Bor	ehole Data	
Date drilling started: $2 - 13 - 65$ Date drilling completed: $2 - 13 - 65$ Location of the source of any surface water used for drilling: Method of dosing and volume of Chlorine used in drilling and deve Logs run (circle all applicable): No log run Electric Gamma Ray Name of organization running log(s): Purpose of borehole (check one): Water Well Geotechnical/Geo	ریم (A elopment: <u>۸ (A</u> ر Density Sonic Neutron	Other:
Seismic SurveyOther (describ If drilling is not related to water well construction		ock

J •

.

Purpose of Well (check one): Home / Industrial Public Supply Irrigation Fish Culture Other:
If a flowing well, method of flow regulation: Valve _ へん Other (describe)
Static Water Level: <u>54</u> feet above or below (circle one) land surface Date measured: <u>7-13-07</u>
Method of Measurement (circle one) steel tape electric tape air line other: String / weight
Well depth: 155 Well grouted to a depth of 16 feet Type of grout (circle one): Neat Cement Bentonite Mix
Casing length: <u>145</u> feet Casing diameter: <u>4</u> inches Type of casing: $\rho \sim \zeta$
Screen length: <u>10</u> feet Screen diameter: <u>4</u> inches Type of screen: $\rho \sim c$
Screen slot size: . O (O inches Setting depth: From 145 feet to 155 feet
Type of completion (circle all applicable): Gravel packed Underreamed Telescoped Open hole Natural Development
Other (describe):
Top of lap pipe or reduction in casing:feet. If telescoped or more than one screen, describe on next page

Form: OLWR-SWR-1A


AUG 0 4 2005 BY: OLWR

H-217

The sketch below only required for water wells

If well telescopes,	show depths on sketch.
Ground Level.	


۰ د

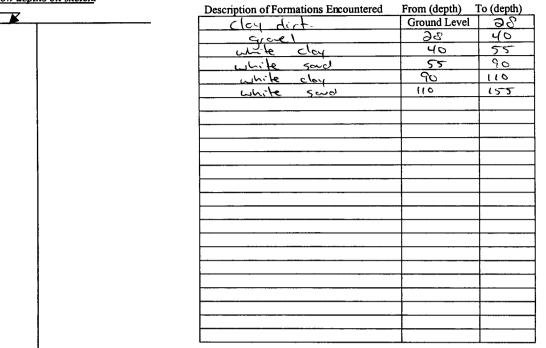

Description of formations encountered must be provided for all

wells and boreholes, unless specifically exempted by regulations

If more than one screen, show location of each on sketch

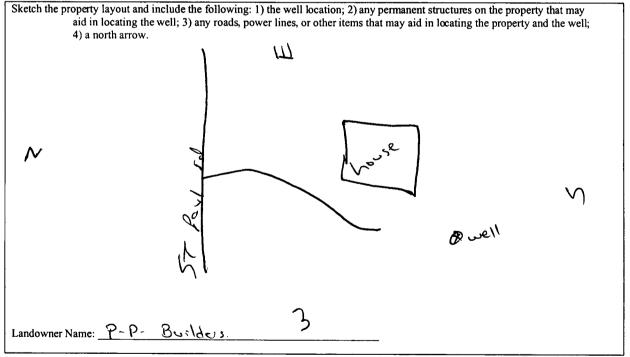

Form: OLWR-SWR-1A

I certify that the well/borehole was drilled, constructed, and completed in accordance with all applicable requirements of the Mississippi Department of Environmental Quality and the Mississippi Department of Health regulations, if applicable, and state laws.

Date

Jones W. Mora 0-620

8-1-05

Signature of Licensee

AUG 0 4 2005 BY: OLW R

RECEIVED

Print Name of Responsible Licensee and License No.

County: Marshall	Part 2 Pump Installer's Completion Report	For Office Use Only:
ermit #:	Mississippi Department of Environmental Quality	Aquifer:
Driller: Jores w. Moser	Office of Land and Water Resources P.O. Box 10631	11 210
Date completed: 7-13-05	Jackson, MS 39289-0631 (601)961-5210	Well #: <u>H-217</u>
Copy information from block on Part 1	(601)354-6938 (fax)	Elevation:

۴. 0

report must be attached and both parts filed with the Department at the above address within 30 days of well completion.					
Well Owner Information		Well Location			
Owner Name: P-P Builders		Latitude: 34.49.851 Longitude: 89.40.719.			
Mailing Address: 9318 ST faul rd.		Method of Lat/Long (check one): Conventional Survey,			
			USGS quad, Hand-held GPS, Survey-grade GPS		ey-grade GPS
Byh. City	alia N Stat	te Zip Code	NE "NW"	4 Sec_13_T_3s	<u>R 5</u>
		- r	Distance D	irection Nearest T	own
Telephone No. (1915	383-0	2897	1/8_Miles	E of worse.	v
	Dumm Trues		1		
	Pump Type Circle one			Power Type Circle one	
Air Lift		Submersible	Diesel Engine		Natural Gas
Air Lift Bucket	Circle one		Diesel Engine Electric Motor	Circle one	Natural Gas Tractor PTO
	Circle one Jet	Submersible		Circle one Gasoline Engine	Tractor PTO
Bucket	Circle one Jet Piston Rotary	Submersible	Electric Motor Windmill Horse Power Rating	Circle one Gasoline Engine Hand Other (specify): of Motor: $3/4$	Tractor PTO
Bucket Centrifugal	Circle one Jet Piston Rotary	Submersible Turbine Flowing Well	Electric Motor Windmill Horse Power Rating	Circle one Gasoline Engine Hand Other (specify):	Tractor PTO

Pump Test Data	Method of Measuring Water Level	
Date Well Tested:	Circle one	
Static Water Level (A): 54 Feet Below Land Surface	Air Line Electric Measuring Line Steel Tape	
Pumping Water Level (B): $\sim A$ Feet Below Land Surface	Other (specify): String / reight	
Drawdown [(B) – (A)]: Feet Below Land Surface	For flowing well, measured shut in head: <u>NA</u> feet	
Test Pumping Rate: Gallons Per Minute	Well yielded <u>1</u> GPM with a drawdown of	
Duration of Pump Test (minimum 4 hours):	\frown \frown feet after \bigcirc \bigcirc hours of pumping	

I HEREBY CERTIFY that the above statements are true to the ba	est of my knowledge.		
Jones w. Masa	Geno w. Mon		
Print Name of Pump Installer and License No. (if applicable)	OSignature of Pump Installer	<u> </u>	
		Form: OLWR-SWR-1B	
		RECEIVED)

AUG 0 4 2005 BY: OLWR