	State Well Report	For Office Use Only:
County: Marshall	Part 1 – Driller's Log Mississippi Department of Environmental Quality	Aquifer:
Permit #:	P.O. Box 10631	Well #: H-242
Driller: Jones W-Mason	Jackson, MS 39289-0631	L. S. Elevation:
Date drilling completed: 13-6-05	(601)961-5210 (601)354-6938 (fax)	E-log #:

State Law requires that this report be prepared by the license holder responsible for the work and filed with the Department at the above address within 30 days of completion of drilling of the well or borehole.

Department at the above address within 50 and 5	Well or Borehole Location		
Information on Well Owner			
(Landowner if borehole is not for a water well)	Latitude: 34 . 49 . 593" Longitude: 89 . 41 . 045"		
Owner Name Poul Morsholl	Method of Lat/Long (circle one): Conventional Survey,		
	Meinod of LavLong (chele one). Convention		
Mailing Address LOT 64	USGS quad, (Hand-held GPS) Survey-grade GPS		
moores Plastation	$12/\pi - 24 pm 5\omega'$		
77100-03	Drw 14 NW 14 Sec 13 Twn 35 Rng 5w		
Byhalia MJ 38611 City State Zip Code			
State Zin Code	Distance Direction Nearest Town		
City Statep +===	Distance Direction Nearest Town		
C 783 - 0897			
Telephone No. (901) 383 - 0897			
Well / Bor	hala Data		
Well / Boro			
Date drilling started: 12-6-05 Date drilling completed: 12-6-	OS Hole demote: 80 Hole diameter: 8		
Date drilling started: 12-6-05 Date drilling completed: 12-6-			
	• • •		
Location of the source of any surface water used for drilling:	NA		
Location of the source of any surface water used for drilling and deve Method of dosing and volume of Chlorine used in drilling and deve	elopment: NA		
Method of doshig and volume of onterne data			
Logs run (circle all applicable). No log run Electric Gamma Ray	y Density Sonic Neutron Other:		
Logs run (circle all applicable). No log run Liceare			
Name of organization running log(s):			
	Magical Investigation Ground Source Heat Pump		
Purpose of borehole (check one): Water Well Geotechnical/Geo	Nogical involugioning		
Scismic SurveyOther (describ If drilling is not related to water well construct	e)		
If drilling is not related to water well construct	on, sup the temainact of mig brook		
	Leisevice Fich Culture Other		
Purpose of Well (check one): Home V Industrial Public Supp	ingation Fish Cultane Outer		
	Purpose of Well (check one): Home / Industrial Public Supply Irrigation Fish Culture Other:		
If a flowing well, method of flow regulation: Valve $\overset{\frown}{}$ Other (describe)			
Static Water Level: 35 feet above of below circle one) land surface Date measured: $13-6-05$			
	distribution (b)		
Method of Measurement (circle one) steel tape electric tape air line other: String / weight			
Well depth: <u>80</u> Well grouted to a depth of <u>10</u> feet Type of grout (circle one): Neat Cement Bentonite Mix			
1	pe of grout (circle one): Neat Cement Bentonite Mix		
Well depth: <u>80</u> wen grouted to a depth of			
Casing length: <u>80'</u> feet Casing diameter: <u>4</u> inches Type of casing: <u>per c</u>			
Casing length: <u>XO</u> feet Casing diameter.			
Screen length: 10 feet Screen diameter: 4 inches Type of screen: $\rho \leq C$			
Screen length: 10 feet Screen diameter:	inches Type of screen		
	20 ALL SID fast		
Second slot size: O(0 inches Setting depth: From	feet toieet		
Screen slot size: <u>010</u> inches Setting depth: From <u>70</u> feet to <u>80</u> feet			
Type of completion (circle all applicable): Gravel packed Underreamed Telescoped Open hole Natural Development			
Type of compression (criede and the provide state of the provide state o			
Other (describe):			
A feet I	a stand the second torget describe on next Daye		
	felescoped or more than one screen, assume on many page		
Top of lap pipe or reduction in casing:	f <u>telescoped or more than one screen, describe on next page</u> Form: OLWR-SWR-1A		

JAN 0 9 2006 BY: OLWR

H-242


The sketch below only required for water wells

If well telescopes, show depths on sketch. Ground Level

Description of formations encountered must be provided for all weils and boreholes, unless specifically exempted by regulations

Description of Formations Encountered	From (depth)	To (depth)
Clay dirt	Ground Level	15
white soud	15	30
white soud	30	80
······································		
		L
	1	
		ļ
l		1

If more than one screen, show location of each on sketch

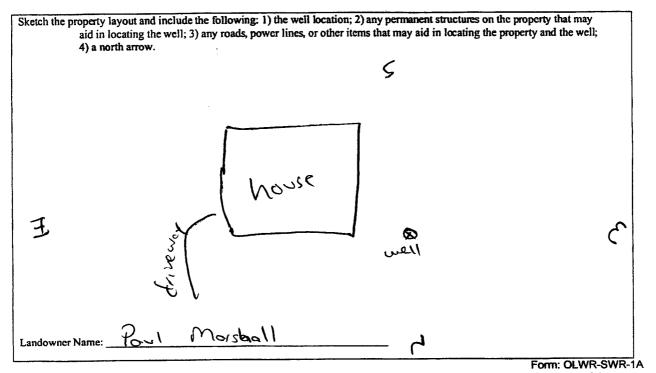

l certify that the well/borehole was drilled, constructed, and completed in accordance with all applicable requirements of the Mississippi Department of Environmental Quality and the Mississippi Department of Health regulations, if applicable, and state

1-4-06

Date

laws, W. More 0-620 20

 $\mathcal{N}_{\mathcal{N}}$

Print Name of Responsible Licensee and License No.

/ Signature of Licensee

JAN 0 9 2006 BY: OLWR

RECEIVED

STATE WI	ELL REPORT
County: Marshall Pump Installer's Permit #: Mississippi Departmer Driller: Jone Low P.O. I Date completed: 12-6-05 Jackson, N	For Office Use Only: s Completion Report nt of Environmental Quality and Water Resources Box 10631 MS 39289-0631 961-5210 54-6938 (fax) Contractor or a licensed pump installer. A copy of Part 1 of the
Pump Type Circle one Air Lift Jet	Power Type Circle onc Diesel Engine Gasoline Engine Natural Gas
Bucket Piston Turbine Centrifugal Rotary Flowing Well Other (specify):	Electric Motor Hand Tractor PTO Windmill Other (specify):
Pump Test Data Date Well Tested: $1 \ge - 6 - 05$ Static Water Level (A): 35 Fect Below Land Surface Pumping Water Level (B): \mathcal{PA} Feet Below Land Surface Drawdown [(B) - (A)]: \mathcal{PA} Feet Below Land Surface Test Pumping Rate: 12 Gallons Per Minute Duration of Pump Test (minimum 4 hours): $2\mathcal{H}$ hours	Method of Measuring Water Level Circle one Air Line Electric Measuring Linc Steel Tape Other (specify): String Steel Tape Other (specify): String Steel Tape For flowing well, measured shut in head: NA feet Well yielded IQ GPM with a drawdown of PA feet after Hours of pumping
I HEREBY CERTIFY that the above statements are true to the best <u>Jones</u> <u>O-620</u> Print Name of Pump Installer and License No. (if applicable)	s of my knowledge. <u>Jeno w.</u> Signature of Pump Installer Form: OLWR-SWR-1B RECEIV ΙΔΝ Ω Ω 20

•

JAN 0 9 2006 BY: OLWR