	State W	ell Report	
County: Marshall		Driller's Log	For Office Use Only:
Permit #:		t of Environmental Quality and Water Resources	Aquifer: Well #: $H - 249$
Driller: Jones w. Mason		Box 10631	
Date drilling completed: $1 - 9 - 04$	(601)	1S 39289-0631 961-5210 4-6938 (fax)	L. S. Elevation:
State Law requires that this repo Department at the above address	rt be prepared by the lic s within 30 days of com	ense holder responsible for t aletion of drilling of the well	he work and filed with th or borehole.
Information on Well	Owner		rehole Location
(Landowner if borehole is not f		Latitude: 34 • 49 . 567	" Longitude: <u>89 • 43</u> ,7
Owner Name Walter Moo		Method of Lat/Long (cir or	
Mailing Address: 71 (cwol	ridge		GPS, Survey-grade GPS
		Sw 1/2 Sec 15	1 1
Byhalia M City Sta	<u>s 38611</u>	NF	
-	-	Distance Direction リーマン Miles ろい	of Userst Town
Telephone No. (66) 838-310	9		
	Well / Bord	hole Data	
Date drilling started: $1 - 9 - 06$ Date d	rilling completed: $1-9-0$	6 Hole depth: 120'	Hole diameter: <u>8</u> '`
Location of the source of any surface wat Method of dosing and volume of Chlorir	ter used for drilling:	رج Ropment: مربلہ	
Logs run (circle all applicable): No log n Name of organization running log(s):			Other:
Logs run (circle all applicable): No log ru	in Electric Gamma Ray	Density Sonic Neutron	
Logs run (circle all applicable): No log n Name of organization running log(s): Purpose of borehole (check one): Water V Seismic	Electric Gamma Ray	Density Sonic Neutron logical Investigation Ground	I Source Heat Pump
Logs run (circle all applicable): No log n Name of organization running log(s): Purpose of borehole (check one): Water V Seismic <u>If drilling is not relate</u>	Well Geotechnical/Geol Survey Other (<i>described</i>	Density Sonic Neutron logical Investigation Ground e) on, skip the remainder of this bl	I Source Heat Pump
Logs run (circle all applicable): No log ru Name of organization running log(5): Purpose of borehole (check one): Water V Seismic If drilling is not related Purpose of Well (check one): Home	Electric Gamma Ray	Density Sonic Neutron logical Investigation Ground e) on, skip the remainder of this bl y Irrigation Fish Culture	I Source Heat Pump ock Other:
Logs run (circle all applicable): No log n Name of organization running log(s): Purpose of borehole (check one): Water V Seismic <u>If drilling is not relate</u>	Electric Gamma Ray	Density Sonic Neutron logical Investigation Ground e) on, skip the remainder of this bl y Irrigation Fish Culture	I Source Heat Pump ock Other:
Logs run (circle all applicable): No log ru Name of organization running log(5): Purpose of borehole (check one): Water V Seismic If drilling is not related Purpose of Well (check one): Home	Vell <u>Geotechnical/Geol</u> Survey Other (<i>describe</i> <i>d to water well constructio</i> Industrial Public Supply on: Valve <u>V</u>	Density Sonic Neutron logical Investigation Ground p on, skip the remainder of this bl y Irrigation Fish Culture Other (describe)	I Source Heat Pump ock Other:
Logs run (circle all applicable): No log run Name of organization running log(5): Purpose of borehole (check one): Water V Seismic If drilling is not related Purpose of Well (check one): Home If a flowing well, method of flow regulation Static Water Level:feet a	Electric Gamma Ray Vell <u>Geotechnical/Geol</u> Survey Other (<i>describe</i> <i>d to water well constructio</i> Industrial Public Supply on: Valve <u>V</u>	Density Sonic Neutron logical Investigation Ground e) <u>m, skip the remainder of this bl</u> y Irrigation Fish Culture Other (describe) land surface Date measured:	I Source Heat Pump ock Other:
Logs run (circle all applicable): No log ru Name of organization running log(5): Purpose of borehole (check one): Water V Seismic If drilling is not related Purpose of Well (check one): Home If a flowing well, method of flow regulation	Image: Electric Gamma Ray Vell Geotechnical/Geol Survey Other (described d to water well construction Industrial Public Supply on: Valve 2^{A} bove or below (circle one) steel tape electric tape	Density Sonic Neutron logical Investigation Ground by Irrigation Fish Culture Other (describe) land surface Date measured: air line other: <u>5</u> +	I Source Heat Pump
Logs run (circle all applicable): No log run Name of organization running log(5): Purpose of borehole (check one): Water W Seismic If drilling is not related Purpose of Well (check one): Home If a flowing well, method of flow regulati Static Water Level:feet a Method of Measurement (circle one)s Well depth: Well grouted to a d	Electric Gamma Ray Vell Geotechnical/Geol Survey Other (<i>describe</i> <i>d to water well constructio</i> Industrial Public Supply on: Valve $Valve Other (Construction) bove or below (circle one) steel tape electric tape epth of 10 feet Type$	Density Sonic Neutron logical Investigation Ground m. skip the remainder of this bl y Irrigation Fish Culture Other (describe) land surface Date measured: air line other: <u>5</u> e of grout (circle one): Neat Cen	I Source Heat Pump
Logs run (circle all applicable): No log run Name of organization running log(S): Purpose of borehole (check one): Water V Seismic If drilling is not relater Purpose of Well (check one): Home If a flowing well, method of flow regulati Static Water Level: feet a Method of Measurement (circle one) = s Well depth: 120° Well grouted to a d Casing length: feet Cas:		Density Sonic Neutron logical Investigation Ground ep <u>on, skip the remainder of this bl</u> y Irrigation Fish Culture Other (describe) land surface Date measured: air line other: <u></u> e of grout (circle one): Neat Cen inches Type of casing:	I Source Heat Pump
Logs run (circle all applicable): No log run Name of organization running log(5): Purpose of borehole (check one): Water V Seismic If drilling is not related Purpose of Well (check one): Home If a flowing well, method of flow regulati Static Water Level: feet a Method of Measurement (circle one) Well depth: Well grouted to a d	Electric Gamma Ray Vell Geotechnical/Geol Survey Other (described d to water well construction Industrial Public Supply on: Valve $Valve Other (Construction bove or below (circle one) steel tape electric tape epth of 10 feet Typeing diameter: 1$	Density Sonic Neutron logical Investigation Ground ep <u>on, skip the remainder of this bl</u> y Irrigation Fish Culture Other (describe) land surface Date measured: air line other: e of grout (circle one): Neat Cem inches Type of casing:	I Source Heat Pump
Logs run (circle all applicable): No log run Name of organization running log(S): Purpose of borehole (check one): Water V Seismic If drilling is not relater Purpose of Well (check one): Home If a flowing well, method of flow regulation Static Water Level:feet a Method of Measurement (circle one)s Well depth: $1 \frac{20}{}$ Well grouted to a d Casing length:feetcast Screen length:feetfeets	Electric Gamma Ray A Geotechnical/Geol SurveyOther (describe d to water well construction IndustrialPublic Supply on: Valve(bove or below (circle one) steel tape electric tape epth offeet Type ing diameter: Setting depth: From	Density Sonic Neutron logical Investigation Ground e) <u>on, skip the remainder of this bl</u> y Irrigation Fish Culture Dther (describe) land surface Date measured: air line other: <u>S</u> + of grout (circle one): Neat Ceminches Type of casing:inches Type of screen:inches Type of screen:inc	Source Heat Pump ockOther: ri~sfmisht hen Bentonite Mix ρUC ρUC ρUC feet
Logs run (circle all applicable): No log ru Name of organization running log(S): Purpose of borehole (check one): Water V Seismic If drilling is not relater Purpose of Well (check one): Home \checkmark If a flowing well, method of flow regulati Static Water Level: \bigcirc feet a Method of Measurement (circle one) s Well depth: $1 \frac{20}{}$ Well grouted to a d Casing length: 110° feet Cas: Screen length: 10° feet Scr Screen slot size: 010° inches	Image: Electric Gamma Ray Vell Geotechnical/Geol Survey Other (describe d to water well construction Industrial Public Supply on: Valve \mathcal{VA} bove or below (circle one) steel tape electric tape epth of \mathcal{IV} feet Type ing diameter: \mathcal{I} Setting depth: From : Gravel packed Unde	Density Sonic Neutron logical Investigation Ground e) <u>on, skip the remainder of this bl</u> y Irrigation Fish Culture Dther (describe) land surface Date measured: air line other: <u>S</u> + of grout (circle one): Neat Ceminches Type of casing:inches Type of screen:inches Type of screen:inc	I Source Heat Pump

FEB 1 0 2006 BY: OLWR

4-249


The sketch below only required for water wells

If well telescopes,	show	depths	on sketch.
Ground Level		-	

<u>on sketch</u> .			
	Description of Formations Encountered	From (depth)	To (depth)
	Clay dirt.	Ground Level	30
	white sourd	30	120
			1
			+
			+
			-
	<u> </u>	· · · · - · · · - · - · - · - · · · ·	
			-
	······································		
	· · · · · · · · · · · · · · · · · · ·		

Description of formations encountered must be provided for all wells and boreholes, unless specifically exempted by regulations

If more than one screen, show location of each on sketch

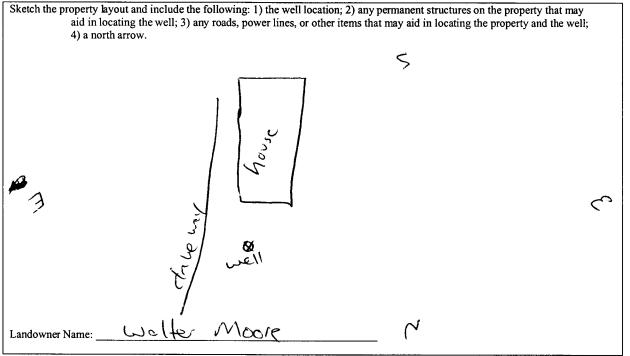

Form: OLWR-SWR-1A

I certify that the well/borehole was drilled, constructed, and completed in accordance with all applicable requirements of the Mississippi Department of Environmental Quality and the Mississippi Department of Health regulations, if applicable, and state

Date

laws. U. Mosa oes

jours w. N 2-3-06

Print Name of Responsible Licensee and License No.

Signature of Licensee

FEB 1 0 2006 BY: OLWR

County: Morshall	Part 2	
	Pump Installer's Completion Report	For Office Use Only:
Permit #:	Mississippi Department of Environmental Quality	Aquifer:
	Office of Land and Water Resources	
Driller: Jones us Mason	P.O. Box 10631	well #: <u>H-249</u>
ate completed: 1-9-06	Jackson, MS 39289-0631	Well #: $\int \int \frac{1}{\sqrt{2}} \frac{1}{\sqrt{2}}$
	(601)961-5210	Elevation:
Copy information from block on Part 1	(601)354-6938 (fax)	

report must be attached and both parts filed with the Department at the above address within 30 days of well completion.			
Well Owner Information	Well Location		
Owner Name: Wolte Moure	Latitude: <u>34.49.567</u> Longitude: <u>89.43.768</u>		
Mailing Address: 71 Conal ridge.	Method of Lat/Long (check one): Conventional Survey,		
	USGS quad, Hand-held GPS, Survey-grade GPS		
Byhalia MS 38611 City State Zip Code	<u>Sw 1/2 NW 1/2 Sec 15 T 35 R 5W</u>		
	Distance Direction Nearest Town		
Telephone No. (667) 838-3107	11/2 Miles Sw of warsow		

Pump Type Circle one		Power Type Circle one			
Air Lift	Jet	Submersible	Diesel Engine	Gasoline Engine	Natural Gas
Bucket	Piston	Turbine	Electric Motor	Hand	Tractor PTO
Centrifugal	Rotary	Flowing Well	Windmill	Other (specify):	
Other (specify):		_	Horse Power Rating	of Motor: 3/4	
Date Pump Installed:	1-9-06		Setting Depth:	28	_feet
Rated Pump Capacity	<u> </u>	Gallons Per Minute	Number of Stages:	11	

Pump Test Data	Method of Measuring Water Level
Date Well Tested: 1- 9-06	Circle one
	Air Line Electric Measuring Line Steel Tape
Static Water Level (A):Feet Below Land Surface	Other (specify): String I weight
Pumping Water Level (B): <u>$\mathcal{N}A$</u> Feet Below Land Surface	
Drawdown [(B) – (A)]:Feet Below Land Surface	For flowing well, measured shut in head:feet
Test Pumping Rate: Gallons Per Minute	Well yielded GPM with a drawdown of
Duration of Pump Test (minimum 4 hours): $\underline{\partial 4}$ hours	- feet after $-$ hours of pumping

I HEREBY CERTIFY that the above statements are true to the best of	f my knowledge.	ŀ
Jones W. Masa	Jens w. Man	
Print Name of Pump Installer and License No. (if applicable)	Signature of Pump Installer	
	Form American American	-U

FEB 1 0 2006 BY: OLWR