

# State Well Report

## Part 1 - Driller's Log

Mississippi Department of Environmental Quality  
Office of Land and Water Resources  
P.O. Box 10631  
Jackson, MS 39289-0631  
(601)961-5210  
(601)354-6938 (fax)

County: Marshall  
 Permit #: \_\_\_\_\_  
 Driller: Jones W. Mason  
 Date drilling completed: 3-27-06

**For Office Use Only:**

Aquifer: \_\_\_\_\_  
 Well #: H-257  
 L. S. Elevation: \_\_\_\_\_  
 E-log #: \_\_\_\_\_

*State Law requires that this report be prepared by the license holder responsible for the work and filed with the Department at the above address within 30 days of completion of drilling of the well or borehole.*

Information on Well Owner <i>(Landowner if borehole is not for a water well)</i>	Well or Borehole Location
Owner Name: <u>Homes Sweet Holmes</u>	Latitude: <u>34° 49' 200"</u> Longitude: <u>89° 40' 432"</u>
Mailing Address: <u>LOT 147</u> <u>Moore's plantation</u>	Method of Lat/Long (circle one): Conventional Survey, <u>26</u>
<u>Byhalia</u> MS <u>38611</u>	USGS quad, <u>(Hand-held GPS)</u> Survey-grade GPS
City State Zip Code	<u>SW</u> <u>1/4</u> <u>NE</u> <u>1/4</u> Sec <u>13</u> <u>✓</u> Twn <u>3s</u> <u>✓</u> Rng <u>5w</u>
Telephone No. <u>(901) 486-9976</u>	Distance Direction Nearest Town <u>12</u> Miles <u>SE</u> of <u>Warsaw</u>

**Well / Borehole Data**

Date drilling started: 3-27-06 Date drilling completed: 3-27-06 Hole depth: 110 Hole diameter: 8"

Location of the source of any surface water used for drilling: NA

Method of dosing and volume of Chlorine used in drilling and development: NA

Logs run (circle all applicable): No log run Electric Gamma Ray Density Sonic Neutron Other: \_\_\_\_\_

Name of organization running log(s): NA

Purpose of borehole (check one): Water Well ✓ Geotechnical/Geological Investigation \_\_\_\_\_ Ground Source Heat Pump \_\_\_\_\_

Seismic Survey \_\_\_\_\_ Other (describe) \_\_\_\_\_

*If drilling is not related to water well construction, skip the remainder of this block*

Purpose of Well (check one): Home ✓ Industrial \_\_\_\_\_ Public Supply \_\_\_\_\_ Irrigation \_\_\_\_\_ Fish Culture \_\_\_\_\_ Other: \_\_\_\_\_

If a flowing well, method of flow regulation: Valve NA Other (describe) \_\_\_\_\_

Static Water Level: 75 feet above or below (circle one) land surface Date measured: 4-3-06

Method of Measurement (circle one) steel tape electric tape air line other: string weight

Well depth: 110 Well grouted to a depth of 10 feet Type of grout (circle one): Neat Cement (Bentonite) Mix

Casing length: 100 feet Casing diameter: 4 inches Type of casing: pvc

Screen length: 10 feet Screen diameter: 4 inches Type of screen: pvc

Screen slot size: 010 inches Setting depth: From 100 feet to 110 feet

Type of completion (circle all applicable): (Gravel packed) Underreamed Telescoped Open hole Natural Development

Other (describe): \_\_\_\_\_

Top of lap pipe or reduction in casing: NA feet. *If telescoped or more than one screen, describe on next page*

Form: OLWR-SWR-1A

RECEIVED

MAY 01 2006


BY: OLWR

H-257

The sketch below only required for water wells

Description of formations encountered must be provided for all wells and boreholes, unless specifically exempted by regulations


If well telescopes, show depths on sketch.

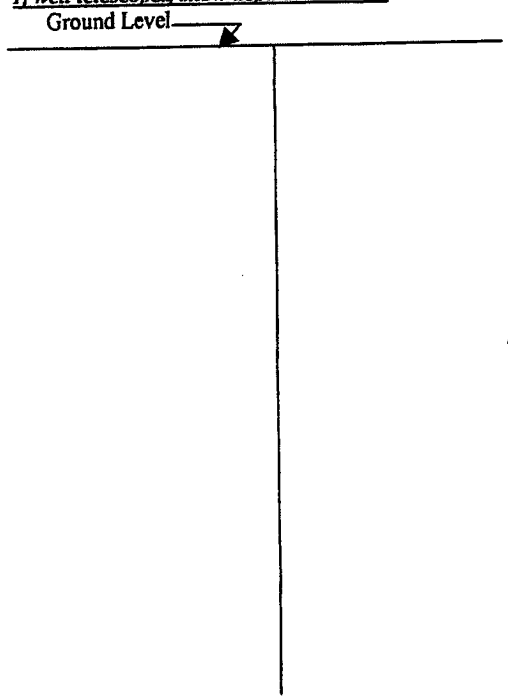

Description of Formations Encountered	From (depth)	To (depth)
clay dirt	Ground Level	20
white clay	20	40
white sand	40	110

If more than one screen, show location of each on sketch

Sketch the property layout and include the following: 1) the well location; 2) any permanent structures on the property that may aid in locating the well; 3) any roads, power lines, or other items that may aid in locating the property and the well; 4) a north arrow.

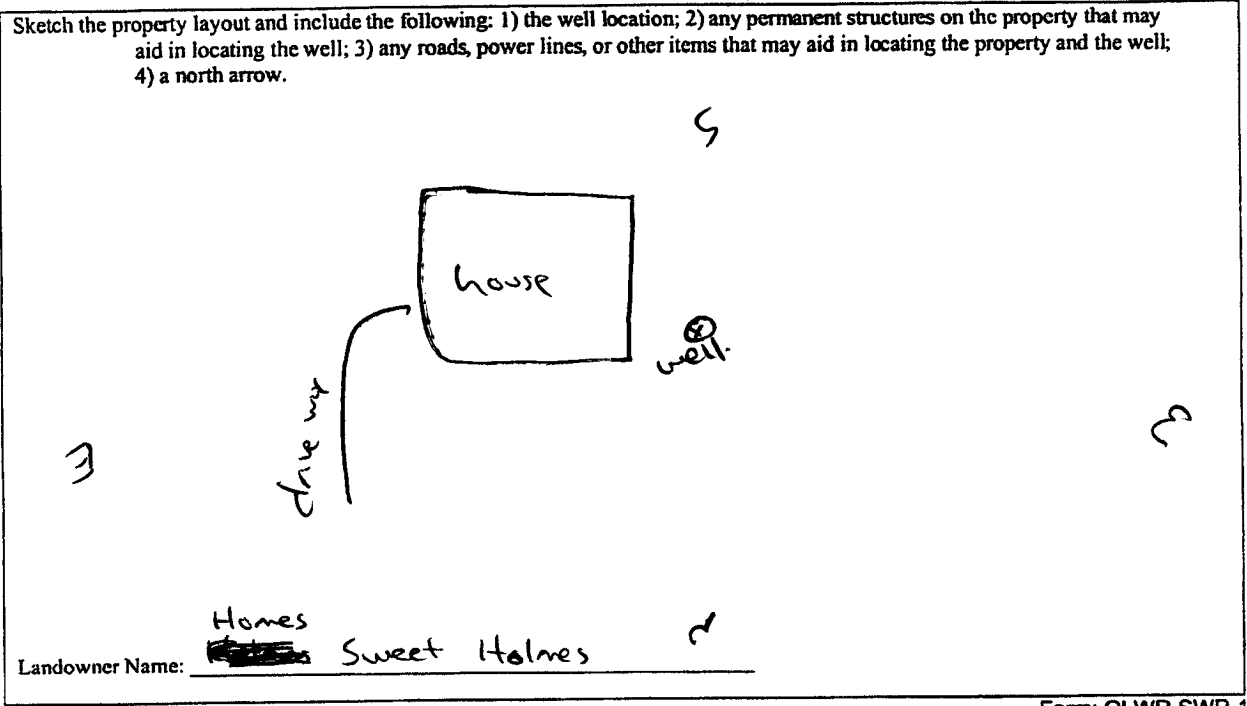

Form: OLWR-SWR-1A

I certify that the well/borehole was drilled, constructed, and completed in accordance with all applicable requirements of the Mississippi Department of Environmental Quality and the Mississippi Department of Health regulations, if applicable, and state laws.

Jones W. Masou 0-620 4-25-06  
 Print Name of Responsible Licensee and License No.      Date

Jones W. Masou  
 Signature of Licensee

**RECEIVED**  
 MAY 01 2006  
 BY: OLWR

# STATE WELL REPORT

## Part 2

**Pump Installer's Completion Report**  
 Mississippi Department of Environmental Quality  
 Office of Land and Water Resources  
 P.O. Box 10631  
 Jackson, MS 39289-0631  
 (601)961-5210  
 (601)354-6938 (fax)

For Office Use Only:

Aquifer: \_\_\_\_\_  
 Well #: H-257  
 Elevation: \_\_\_\_\_

County: Marshall  
 Permit #: \_\_\_\_\_  
 Driller: Jones w. Mason  
 Date completed: 4-3-06

*Copy information from block on Part 1*

*This part of the report must be completed by a licensed water well contractor or a licensed pump installer. A copy of Part 1 of the report must be attached and both parts filed with the Department at the above address within 30 days of well completion.*

Well Owner Information	Well Location
Owner Name: <u>Homes Sweet Homes</u>	Latitude: <u>34.49.200</u> Longitude: <u>89.40.432</u>
Mailing Address: <u>Box 147</u>	Method of Lat/Long (check one): Conventional Survey <input type="checkbox"/> <sup>12</sup> <sub>26</sub>
<u>Moore's plantation</u>	USGS quad _____, Hand-held GPS <input checked="" type="checkbox"/> , Survey-grade GPS _____
<u>Beholia MS 38611</u>	<u>SW 1/4 NW 1/4 Sec 13 T 3s R 5w</u>
City State Zip Code	Distance Direction Nearest Town
Telephone No. <u>(901) 486-9976</u>	<u>1/2</u> Miles <u>SE</u> of <u>Warsaw</u>

Pump Type Circle one	Power Type Circle one
Air Lift      Jet <u>Submersible</u>	Diesel Engine      Gasoline Engine      Natural Gas
Bucket      Piston      Turbine	<u>Electric Motor</u> Hand      Tractor PTO
Centrifugal      Rotary      Flowing Well	Windmill      Other (specify): _____
Other (specify): _____	Horse Power Rating of Motor: <u>3/4</u>
Date Pump Installed: <u>4-3-06</u>	Setting Depth: <u>100</u> feet
Rated Pump Capacity: <u>12</u> Gallons Per Minute	Number of Stages: <u>11</u>

Pump Test Data	Method of Measuring Water Level Circle one
Date Well Tested: <u>4-3-06</u>	Air Line      Electric Measuring Line      Steel Tape
Static Water Level (A): <u>75</u> Feet Below Land Surface	Other (specify): <u>String Weight</u>
Pumping Water Level (B): <u>NA</u> Feet Below Land Surface	For flowing well, measured shut in head: <u>NA</u> feet
Drawdown [(B) - (A)]: <u>NA</u> Feet Below Land Surface	Well yielded <u>12</u> GPM with a drawdown of
Test Pumping Rate: <u>12</u> Gallons Per Minute	<u>NA</u> feet after <u>24</u> hours of pumping
Duration of Pump Test (minimum 4 hours): <u>24</u> hours	

I HEREBY CERTIFY that the above statements are true to the best of my knowledge.

Jones w. Mason  
 Print Name of Pump Installer and License No. (if applicable)

Jones w. Mason  
 Signature of Pump Installer

Form: OLWR-SWR-1B

RECEIVED

MAY 01 2006

BY: OLWR