County: <u>Morshall</u> Permit #: Driller: <u>Jmes</u> w. <u>Mosco</u> Date drilling completed: <u>11-9-06</u> State Law requires that this report Department at the above address	(601)354-69 (601)354-69 (601)354-69 (601)354-69 (601)354-69 (601)354-69 (601)354-69 (601)354-69 (601)354-69	er's Log Environmental Quality Vater Resources 0631 2289-0631 5210 38 (fax)	For Office Use Only: Aquifer:
Information on Well ((Landowner if borehole is not fo	Dwner	Well or Bor	ehole Location
Owner Name Chris Robert	Lat	tude: 34 • 49 , 200 ,	23): Conventional Survey,
Mailing Address: LOT 146 D	udler place Me	hod of Lat/Long (circle one): Conventional Survey,
		USGS quad, Hand-held GPS, Survey-grade GPS	
<u>Moores ploutot</u> Byholia m City Star	$\frac{38611}{\text{zip Code}}$	ance Direction	Twn $3s$ Rng 5ω Nearest Town
Telephone No. (<u>101)</u> 438 - 2813	a	12 Miles SE of	worsow
	Well / Borehole	Data	
Date drilling started: $\frac{11-9-06}{10}$ Date dri	lling completed: 11-9-06	Hole depth: <u>136</u>	Hole diameter: <u>63/4</u>
Location of the source of any surface wate Method of dosing and volume of Chlorine	used in drilling and developme		
Logs run (circle all applicable): No log run Name of organization running log(s):) Electric Gamma Ray Der	sity Sonic Neutron O	ther:
Purpose of borehole (check one): Water We	ellGeotechnical/Geological	Investigation Ground S	ource Heat Pump
Seismic S	Survey Other (describe)		
	to water well construction, skip		
Purpose of Well (check one): Home In			
If a flowing well, method of flow regulation			
Static Water Level: 69 feet abo			
			vg lineight
Well depth: <u>136</u> . Well grouted to a dep			
Casing length: 126 feet Casing	g diameter: inch	es Type of casing:	000
Screen length: <u>i S</u> feet Scree	n diameter: <u> </u>	es Type of screen:	DUC
Screen slot size: <u>()</u> inches			
Type of completion (circle all applicable): (le Natural Development
	Other (describe):		
Top of lap pipe or reduction in casing:			

NOV 2 8 2006 BY: OLWR


H-290

The sketch below only required for water wells

If well telescopes, show depths on sketch. Ground Level <u>Description of formations encountered must be provided for all</u> wells and boreholes, unless specifically exempted by regulations

scription of Formations Encountered	From (depth) Ground Level	20
while clay	99	45
white soud	45	65
white clay	65	70
white clay	70	141

If more than one screen, show location of each on sketch

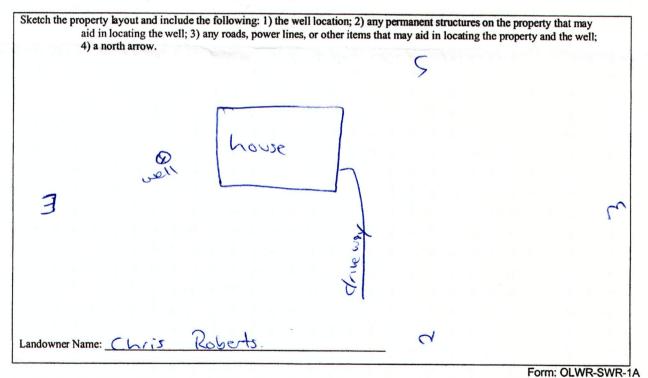

I certify that the well/borehole was drilled, constructed, and completed in accordance with all applicable requirements of the Mississippi Department of Environmental Quality and the Mississippi Department of Health regulations, if applicable, and state laws.

W. Moson

11-23-06 0-620

Date

Print Name of Responsible Licensee and License No.

Signature of Licensee

RECEIVED NOV 28 2006 BY: OLWR

	STATE W	ELL REPORT		
County: <u>Marshall</u> Permit #: Driller: <u>Jaco</u> <u>w. Masco</u> Date completed: <u>1(-10-06</u> <u>Copy information from block on Part 1</u>	Part 2 Pump Installer's Completion Report Mississippi Department of Environmental Quality Office of Land and Water Resources P.O. Box 10631 Jackson, MS 39289-0631 (601)961-5210 (601)354-6938 (fax)		For Office Use Only: Aquifer: Well #: <u>H-290</u> Elevation:	
This part of the report must be completed	d by a licensed water well	l contractor or a licensed pump i	installer. A copy of Part 1 of the	
report must be attached and both parts fi Well Owner Informa	ation		lays of well completion. Il Location	
Owner Name: Chris Roberts		Latitude: 34-49- 200	Latitude: 34-49- 200 Longitude: 89- 40- 38(
Mailing Address: LOT 146 Dudley Place		Method of Lat/Long (check or	Method of Lat/Long (check one): Conventional Survey,	
Maares Plantation Byhalia Ms 38611 City State Zip Code		USGS quad, Hand-held	USGS quad, Hand-held GPS	
		540 1/ NE1/ Sec 13 T 35 R 5W		
Shy State	Lip Code	Distance Direction	Nearest Town	
Telephone No. (901) 438-3813		12 Miles SE of Worsow		
Ритр Туре		Pa	wer Type	
Circle one			ircle one	
Air Lift Jet 🤇	Submersible	Diesel Engine Gasolin	ne Engine Natural Gas	
Bucket Piston	Turbine	Electric Motor Hand	Tractor PTO	
Centrifugal Rotary	Flowing Well	Windmill Other	(specify):	
Other (specify):		Horse Power Rating of Motor	314	
Date Pump Installed: ([(0 - 0 6		Setting Depth:	}Ofeet	
Rated Pump Capacity:	_Gallons Per Minute	Number of Stages:) (
Pump Test Data			asuring Water Level	
Date Well Tested:	0		ircle one	
Static Water Level (A):Feet Below Land Surface		Air Line Electric Measuring Line Steel Tape		
Pumping Water Level (B): <u>M</u> Feet	Below Land Surface	Other (specify): String	weight	
		For flowing well measured sh	out in head: MA feet	
Drawdown [(B) - (A)]:	t Below Land Surface	r or no mig won, mousured sh		
Drawdown [(B) – (A)]:Feet	t Below Land Surface _Gallons Per Minute		GPM with a drawdown of	

I HEREBY CERTIFY that the above statements are true to the best of	f my knowledge.	
Jones W-Mason. 0-620	Gen w. Man	RECEIVED
Print Name of Pump Installer and License No. (if applicable)	Signature of Pump Installer	
	En el Rock en St	Form: OLWR-SWR-1B NOV 2 8 2006

BY: OLWR