State W	ell Report		
County Marcaha V Part 1-1	Driller's Log For Office Use Only:		
Mississippi Departmer	and Water Resources Box 10631 Well #: <u>H-299</u>		
	Box 10631 Well #: $H = 2.79$		
Jackson, N	AS 39289-0631 L. S. Elevation:		
	961-5210 4-6938 (fax) E-log #:		
State Law requires that this report be prepared by the license holder responsible for the work and filed with the Department at the above address within 30 days of completion of drilling of the well or borehole.			
Information on Well Owner	Well or Borehole Location		
(Landowner if borehole is not for a water well)	Latitude 34 . 47 , 370, Longitude: 87 . 42, 593,		
Owner Name Tores	Latitude 34.47 , 370 , Longitude: 81.42 , 573 , " 22 Method of Lat/Long (circle one): Conventional Survey, 35		
Mailing Address: 650 wotson rd			
	USGS quad, Hand-held GPS Survey-grade GPS		
Bubalia Aus 30KII JSE 1/2 Sec 27 Twn 35 Rng Sw			
Byholia Ms 30511 City State Zip Code	تالیک Distance Direction Nearest Town المحکمی of محکمی		
Telephone No. (901) 383-0357	Miles of		
Well / Bor			
Date drilling started: 3-24-67 Date drilling completed: 3-24-	67 Hole depth: 150' Hole diameter: 63/4		
Location of the source of any surface water used for drilling: Method of dosing and volume of Chlorine used in drilling and development: NA			
Logs run (circle all applicable): No log run Electric Gamma Ray Density Sonic Neutron Other:			
Purpose of borehole (check one): Water Well Celeventer Geotechnical/Geological Investigation Ground Source Heat Pump			
Seismic Survey Other (<i>describe</i>) If drilling is not related to water well construction, skip the remainder of this block			
Purpose of Well (check one): Home 🖌 Industrial Public Supply Irrigation Fish Culture Other:			
If a flowing well, method of flow regulation: Valve Other (describe)			
Static Water Level: 85 feet above or felow (circle one) land surface Date measured: 3-34-07			
Method of Measurement (circle one) steel tape electric tape air line other: String lueight.			
Well depth: 150 Well grouted to a depth of 10 feet Type of grout (circle one): Neat Cement Bentonite Mix			
Casing length: 130 feet Casing diameter: 4 inches Type of casing: psc			
Screen length: <u>20</u> feet Screen diameter: <u>4</u> inches Type of screen: <u>puc</u>			
Screen slot size: <u>010</u> inches Setting depth: From <u>130</u> feet to <u>150</u> feet			
Type of completion (circle all applicable): Gravel packet Underreamed Telescoped Open hole Natural Development			
Other (describe):			
Top of lap pipe or reduction in casing: feet. If telescoped or more than one screen, describe on next page			

• •

Form: OLWR-SWR-1A

APR 2 3 2007 BY: OLWR

H-299


The sketch below only required for water wells

If well telescopes, show depths on sketch. Ground Level_

Description of formations encountered must be provided for all wells and boreholes, unless specifically exempted by regulations

Description of For	dirti	Ground Level	ð
	Sand	35	6
white	clay	60	6
white	Sand	85	13
	· - · · · · · · · · · · · · · · · · · ·		
	····		
			<u> </u>
		·	
			ļ

If more than one screen, show location of each on sketch

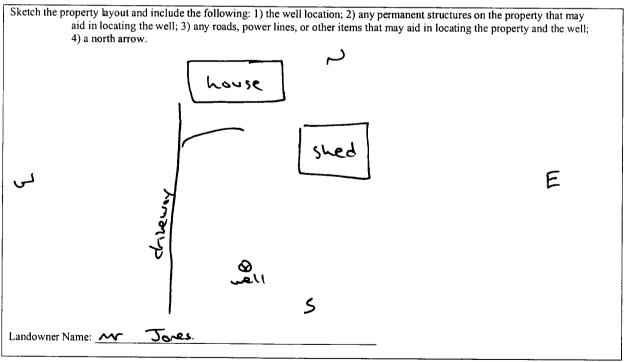

Form: OLWR-SWR-1A

I certify that the well/borehole was drilled, constructed, and completed in accordance with all applicable requirements of the Mississippi Department of Environmental Quality and the Mississippi Department of Health regulations, if applicable, and state laws

Jones w. Messon0-6204-19-01Jeno w. MessonPrint Name of Responsible Licensee and License No.DateSignature of Licensee

RECEIVED APR 2 3 2007 **BY: OLWR**

County: Marshall	Part 2	For Office Use Only:
Permit #:	Pump Installer's Completion Report Mississippi Department of Environmental Quality	Aguifer:
Driller: Jones w. Mason	Office of Land and Water Resources	
Date completed: 3-34-07	P.O. Box 10631 Jackson, MS 39289-0631 (601)961-5210	well #: <u>H-299</u>
Copy information from block on Part 1	(601)354-6938 (fax)	Elevation:

n ke

report must be attached and both parts filed with the Department at the above address within 30 days of well completion.		
Well Owner Information	Well Location	
Owner Name: M Jones Mailing Address: 650 wotson rd	Latitude: 34. 47. 370 Longitude: 89.42.593 22 Method of Lat/Long (check one): Conventional Survey,	
Byuelia <u>MS</u> <u>38611</u> City State Zip Code Telephone No. (<u>901)</u> <u>383-0357</u>	USGS quad, Hand-held GPS_, Survey-grade GPS ハンレ ½ <u>SE</u> ½ Sec <u>27</u> T <u>35</u> R <u>5</u> Distance Direction Nearest Town <u>118 Miles い</u> of ひまちのイ	
Pump Type Circle one	Power Type Circle one	
Circle one	Circle one	
Circle one Air Lift Jet Submersible	Circle one Diesel Engine Gasoline Engine Natural Gas	
Circle one Air Lift Jet Submersible Bucket Piston Turbine	Circle one Diesel Engine Gasoline Engine Natural Gas Electric Moto Hand Tractor PTO	
Circle oneAir LiftJetBucketPistonCentrifugalRotaryFlowing Well	Circle one Diesel Engine Gasoline Engine Natural Gas Electric Motor Hand Tractor PTO Windmill Other (specify):	

Pump Test Data	Method of Measuring Water Level
Date Well Tested: 3-34-07	Circle one
Static Water Level (A): 85 Feet Below Land Surface	Air Line Electric Measuring Line Steel Tape
Pumping Water Level (B): Feet Below Land Surface	Other (specify): <u>String</u> (weight
Drawdown [(B) – (A)]:	For flowing well, measured shut in head:
Test Pumping Rate: Gallons Per Minute	Well yielded (> GPM with a drawdown of
Duration of Pump Test (minimum 4 hours): <u> </u>	feet after <u><u></u><u></u><u></u>hours of pumping</u>

I HEREBY CERTIFY that the above statements are true to the best of my knowledge.		
Jones W. Mason 0-620	Gers w. Mara	
Print Name of Pump Installer and License No. (if applicable)	Signature of Pump Installer	
	Form: OLWR-SWR-1B	

APR 2 3 2007 BY: OLWR