r · · · · · · · · · · · · · · · · · · ·	1 State Well Report	r
County: Marshall	Part 1 – Driller's Log	For Office Use Only:
	Mississippi Department of Environmental Quality	Aquifer:
Permit #:	Office of Land and Water Resources	4-275
Driller: Jones W. Moson	P.O. Box 10631	Well #: <u><u><u></u><u></u><u></u><u></u><u></u><u></u><u></u><u></u><u></u><u></u><u></u><u></u><u></u><u></u><u></u><u></u><u></u><u></u></u></u>
	Jackson, MS 39289-0631	L. S. Elevation:
Date drilling completed: $\frac{\partial - \partial l}{\partial \theta}$	(601)961-5210	
	(601)354-6938 (fax)	E-log #:

State Law requires that this report be prepared by the license holder responsible for the work and filed with the Department at the above address within 30 days of completion of drilling of the well or borehole.

Information on Well Owner	Well or Borehole Location		
(Landowner if borehole is not for a water well)			
Owner Name Ken Hole	Latitude: <u>34 • 49 ,</u> <u>362</u> ," Longitude: <u>89 • 40 , 526</u> ," 16		
Mailing Address: LUT # 119	Method of Lat/Long (circle one): Conventional Survey,		
Moores Plantation	USGS quad, (Hand-held GPS) Survey-grade GPS 5×13 Twn 35 Rng 5 \sim		
Byhalia Ms 38611 City State Zip Code	N W SE Direction Nearest Tour		
Telephone No. (901) 494-6089	NW SE Direction Nearest Town <u>12</u> Miles <u>SE</u> of <u>worsow</u>		
Well / Bore	hole Data		
Date drilling started: $\frac{\partial^2 \partial b \delta}{\partial t}$ Date drilling completed: $\frac{\partial^2 \partial b \delta}{\partial t}$ Hole depth: <u>$C \int G$</u> Hole diameter: <u>$\delta^3 / 4$</u>			
Location of the source of any surface water used for drilling: <u>M</u> Method of dosing and volume of Chlorine used in drilling and development: M			
Logs run (circle all applicable): No log run Electric Gamma Ray Density Sonic Neutron Other:			
Purpose of borehole (check one): Water Well Geotechnical/Geological Investigation Ground Source Heat Pump			
Seismic SurveyOther (describe) If drilling is not related to water well construction, skip the remainder of this block			
Purpose of Well (check one): Home 🖌 Industrial Public Supply Irrigation Fish Culture Other:			
If a flowing well, method of flow regulation: Valve O	ther (describe)		
Static Water Level: feet above or below circle one) land surface Date measured: $2 - 34 - 08$			
Method of Measurement (circle one) steel tape electric tape air line other: String Iweight			
Well depth: 95 Well grouted to a depth of 10 feet Type of grout (circle one): Neat Cement Bentonite Mix			
Casing length: 85 feet Casing diameter: 4 inches Type of casing: Put			
Screen length: <u>()</u> feet Screen diameter: <u>4</u> inches Type of screen: ρ_{2}			
Screen slot size: -010 inches Setting depth: From 85 feet to 95 feet			
Type of completion (circle all applicable) Gravel packed Under			
Other (describe):	M		
Top of lap pipe or reduction in casing: feet. If telescoped or more than one screen, describe on next page			
	Form: OLWR-SWR-1A		

RECEIVED MAR 2 0 2008 BY: OLWR

H-325


The sketch below only required for water wells

If well telescopes, show depths on sketch. Ground Level_

Description of formations encountered must be provided for all wells and boreholes, unless specifically exempted by regulations

Description of Formations Encountered	From (depth)	
clay dirt		10
red Soud	0	15
white clay	15	40
white sand	40	95
1988 - 1980 - 11 anno 1		
the in-		

If more than one screen, show location of each on sketch

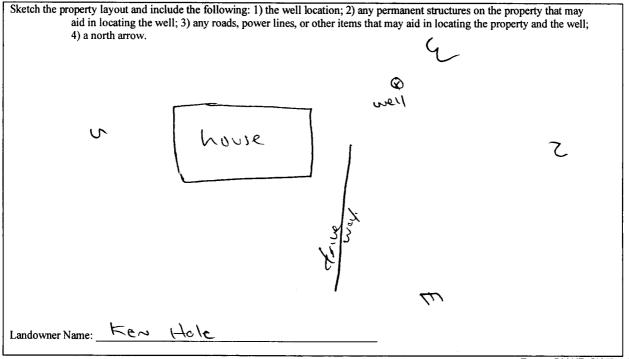

Form: OLWR-SWR-1A

I certify that the well/borehole was drilled, constructed, and completed in accordance with all applicable requirements of the Mississippi Department of Environmental Quality and the Mississippi Department of Health regulations, if applicable, and state
 laws.
 Jones w. Moson
 0-620
 3-15-08
 Jens w. Mon

 Print Name of Responsible Licensee and License No.
 Date
 Signature of Licensee
 RECEIVED
laws.

MAR 2 0 2008 **BY: OLWR**

ounty: Marshall	Part 2 Pump Installer's Completion Report	For Office Use Only:
ermit #:	Mississippi Department of Environmental Quality	Aquifer:
riller: Jones w. Masan	Office of Land and Water Resources P.O. Box 10631	4- 279
ate completed: <u>2-24-08</u>	Jackson, MS 39289-0631 (601)961-5210	Well #:
opy information from block on Part 1	(601)354-6938 (fax)	Elevation:

Well Owner Information	Well Location	
Owner Name: Ken Hole	Latitude: 34, 49, 262 Longitude: 89, 40, 520	
Mailing Address: LOT # 119	Method of Lat/Long (check one): Conventional Survey,	
monics plantation	USGS quad, Hand-held GPS_1, Survey-grade GPS	
Byholio ms 38611 City State Zip Code	<u>SE 1/ NW 1/ Sec 13 T3S R SW</u>	
	Distance Direction Nearest Town	
Telephone No. (901) 494 - 6089	1/2 Miles SE of Warson	
Pump Type Circle one	Power Type Circle one	

Circle one			Circle one		
Air Lift	Jet	Submersible	Diesel Engine	Gasoline Engine	Natural Gas
Bucket	Piston	Turbine	Electric Motor	Hand	Tractor PTO
Centrifugal	Rotary	Flowing Well	Windmill	Other (specify):	
Other (specify):			Horse Power Rating	g of Motor:3/4	
Date Pump Installed:	2-24-0	8	Setting Depth:	60	feet
Rated Pump Capacity	y:(\)	Gallons Per Minute	Number of Stages:	.8	

Pump Test Data	Method of Measuring Water Level Circle one		
Date Well Tested: <u>J-J4-08</u> Static Water Level (A): <u>40</u> Feet Below Land Surface Pumping Water Level (B): <u>A</u> Feet Below Land Surface	Air Line Electric Measuring Line Steel Tape Other (specify): <u>String Lineight</u>		
Drawdown $[(B) - (A)]$: <u>MA</u> Feet Below Land Surface Test Pumping Rate: <u>(O</u> Gallons Per Minute Duration of Pump Test (minimum 4 hours): <u>$\partial \mathcal{H}$</u> hours	For flowing well, measured shut in head: $\[\ \ \ \ \ \ \ \ \ \ \ \ \ \ \ \ \ \$		

I HEREBY CERTIFY that the above statements are true to the best of a	my knowledge.	
Jores withoson 0-620	Ques w. Man	
Print Name of Pump Installer and License No. (if applicable)	Signature of Pump Installer	DECENTER
		Form

MAR 2 0 2008 BY: OLWR