		Vell Report	For Office Use Only:
County: Morshall		Driller's Log	
Permit #:	Mississippi Department of Environmental Quality Office of Land and Water Resources		Aquifer: Well #: H-33
Driller: Jonesw. Moscon	P.O. Box 2309 Jackson, MS 39225		Well #:
Date drilling completed: 5-28-08)961- 5210 31- 5228 (fax)	E-log #:
State Law requires that this repo	」 ort be prepared by the lid	cense holder responsible for	
Department at the above address	s within 30 days of com	pletion of drilling of the wel	l or borehole.
Information on Well			orehole Location
(Landowner if borehole is not j		Latitude: <u>34.49</u> ,600 34 Method of Lat/Long (circle of	F. Longitude: 89. 42,6
Owner Name Tommy Hun Mailing Address: Lot 29 Strick	gres	Method of Lat/Long (circle o	ne): Conventional Survey,
	und ta . Ichny		I GPS, Survey-grade GPS
Ruhalia N	38611	SE 1/ NW /4 Sec 14	
<u>Byholia</u> N City Sta	ate Zip Code	Distance Direction	Nearest Town
Telephone No. (901) 413-1682	<u> </u>	Miles <u>5</u> ω	of warsow
	Well / Bor	ehole Data	
Date drilling started: $5 - 28 - 08$ Date dr			
Logs run (circle an applicable). No log ru	Electric Gamma Ray	Density Sonic Neutron	Other:
Name of organization running log(s): Purpose of borehole (check one): Water W	A		
Name of organization running log(s): Purpose of borehole (check one): Water W Seismic	/ell / Geotechnical/Geol Survey Other (<i>describe</i>	logical Investigation Ground	d Source Heat Pump
Name of organization running log(s): Purpose of borehole (check one): Water W Seismic	Vell Geotechnical/Geol Survey Other (describe to water well construction	logical Investigation Ground z) <i>on, skip the remainder of this bl</i>	d Source Heat Pump
Name of organization running log(s): Purpose of borehole (check one): Water W Seismic <i>If drilling is not related</i> Purpose of Well (check one): Home <u>1</u>	Vell Geotechnical/Geol Survey Other (<i>describe</i> <u>d to water well construction</u> ndustrial Public Supply	logical Investigation Ground 2) m, skip the remainder of this bl y Irrigation Fish Culture	d Source Heat Pump
Name of organization running log(s): Purpose of borehole (check one): Water W Seismic <i>If drilling is not related</i>	Vell Geotechnical/Geol Survey Other (<i>describe</i> <u>d to water well construction</u> industrial Public Supply on: Valve <u>Velve</u> C	logical Investigation Ground p p., skip the remainder of this bl y Irrigation Fish Culture Other (describe)	I Source Heat Pump ock Other:
Name of organization running log(s): Purpose of borehole (check one): Water W Seismic <i>If drilling is not related</i> Purpose of Well (check one): Home <u>1</u> If a flowing well, method of flow regulation	NA /ell Geotechnical/Geol Survey Other (describe 1 to water well construction industrial Public Supply on: Valve NA bove or below (sircle one) Construction	logical Investigation Ground p p., skip the remainder of this bl y Irrigation Fish Culture Other (describe)	1 Source Heat Pump ock Other: 5 - 3 1- () c ^p
Name of organization running log(s): Purpose of borehole (check one): Water W Seismic If drilling is not related Purpose of Well (check one): Home // If a flowing well, method of flow regulation Static Water Level: feet all Method of Measurement (circle one) s Well depth: Well grouted to a definition Well depth: Well grouted to a definition Nethod of Measurement (circle one) s	MA Vell Geotechnical/Geol Survey Other (describe A to water well construction industrial Public Supply on: Valve M bove of below gircle one) Construction teel tape electric tape epth of 10 feet Type	logical Investigation Ground p Ground y Irrigation Fish Culture Other (describe) land surface Date measured: air line other: e of grout (circle one): Neat Cerr	d Source Heat Pump <u>ock</u> Other: 5-31-000 <u>sring 1 sneight</u> here Bentonite Mix
Name of organization running log(s): Purpose of borehole (check one): Water W Seismic If drilling is not related Purpose of Well (check one): Home \checkmark If a flowing well, method of flow regulation Static Water Level: 60 feet all Method of Measurement (circle one) s Well depth: 140 Well grouted to a dec Casing length: 130 feet Casin	MA Vell Geotechnical/Geol Survey Other (describe A to water well construction Industrial Public Supply on: Valve M bove of below bircle one) Construction teel tape electric tape epth of 10 feet Type ng diameter: 4	logical Investigation Ground p Ground y Irrigation Fish Culture Other (describe) land surface Date measured: air line other: c of grout (circle one): Neat Cem inches Type of casing:	d Source Heat Pump ock Other: $5 - 31 - 01c^{D}$ $5 - 31 - 01c^{D}$
Name of organization running log(s): Purpose of borehole (check one): Water W Seismic If drilling is not related Purpose of Well (check one): Home 1/2 If a flowing well, method of flow regulation Static Water Level: 60 feet all Method of Measurement (circle one) s Well depth: 140 Well grouted to a dec Casing length: 130 feet Casin Screen length: 10 feet Scree	MA Vell Geotechnical/Geol Survey Other (describe A to water well construction industrial Public Supply on: Valve M bove of below (sircle one) C teel tape electric tape epth of 10 feet Type ng diameter: 4 4 4 wen diameter: 4 4 4	logical Investigation Ground p Ground y Irrigation Fish Culture ther (describe) land surface Date measured: air line other: e of grout (circle one): Neat Cerr inches Type of casing: inches Type of screen:	d Source Heat Pump ock Other: 5-31-00 file one ign f ment Bentonite Mix puc
Name of organization running log(s): Purpose of borehole (check one): Water W Seismic If drilling is not related Purpose of Well (check one): Home \checkmark If a flowing well, method of flow regulation Static Water Level: 60 feet all Method of Measurement (circle one) s Well depth: 140 Well grouted to a dec Casing length: 130 feet Casin	MA Vell Geotechnical/Geol Survey Other (describe A to water well construction industrial Public Supply on: Valve M bove of below (sircle one) C teel tape electric tape epth of 10 feet Type ng diameter: 4 4 4 wen diameter: 4 4 4	logical Investigation Ground p Ground y Irrigation Fish Culture ther (describe) land surface Date measured: air line other: e of grout (circle one): Neat Cerr inches Type of casing: inches Type of screen:	d Source Heat Pump ock Other: 5-31-00 file one ign f ment Bentonite Mix puc
Name of organization running log(s): Purpose of borehole (check one): Water W Seismic If drilling is not related Purpose of Well (check one): Home 1/2 If a flowing well, method of flow regulation Static Water Level: 60 feet all Method of Measurement (circle one) s Well depth: 140 Well grouted to a dec Casing length: 130 feet Casin Screen length: 10 feet Scree	NA Yell Geotechnical/Geol Survey Other (describe A to water well construction Industrial Public Supply Industrial Industrial Industrial In	logical Investigation Ground p Ground p Ground p Irrigation Fish Culture p Irrigation Fish Culture Dther (describe) land surface Date measured: air line other: air line other: of grout (circle one): Neat Cem inches Type of casing: inches Type of screen: feet to reamed Telescoped Open	d Source Heat Pump ock Other: $5 - 31 - 01 c^{p}$ f(ing creight) here Bentonite Mix p = c p = c 146feet
Name of organization running log(s): Purpose of borehole (check one): Water W Seismic If drilling is not related Purpose of Well (check one): Home If a flowing well, method of flow regulation Static Water Level: feet all Method of Measurement (circle one) si Well depth: Well grouted to a dec Casing length: Well grouted to a dec Screen length: feet Screen Screen slot size: Screen inches	MA Yell Geotechnical/Geol Survey Other (describe A to water well construction Industrial Public Supply Industrial Industrial Industrial Public Supply Industrial Industrial Industrial	logical Investigation Ground p Ground p Ground p Irrigation Fish Culture p Irrigation Fish Culture Dther (describe) land surface Date measured: air line other: air line other: of grout (circle one): Neat Cem inches Type of casing: inches Type of screen: feet to reamed Telescoped Open	d Source Heat Pump ock Other: $5 - 31 - 01c^{p}$ f(ing creight) here Bentonite Mix pci (pci (f(ing creight)
Name of organization running log(s): Purpose of borehole (check one): Water W Seismic If drilling is not related Purpose of Well (check one): Home If a flowing well, method of flow regulation Static Water Level: feet all Method of Measurement (circle one) si Well depth: Well grouted to a dec Casing length: Well grouted to a dec Screen length: feet Screen Screen slot size: Screen inches	NA Yell Geotechnical/Geol Survey Other (describe) Industrial Public Supply inteel tape electric tape epth of 10 feet Type ing diameter: 4 Setting depth: From Gravel packed Under Other (describe): 4	logical Investigation Ground p Ground Ground p Irrigation Fish Culture p Irrigation Fish Culture Dther (describe) land surface Date measured: air line other: air line other: e of grout (circle one): Neat Cem inches Type of casing: inches Type of screen: feet to reamed Telescoped Open	d Source Heat Pump ack Other: $5 - 31 - 0c^{p}$ f(ing creight) areight here Bentonite Mix poc poc 146 feet hole Natural Development

.

BY: OLWR

92

50


60

85

140

The sketch below only required for water wells


If well telescopes,	show	depths	on	<u>sketch</u> .
Ground Level		7		

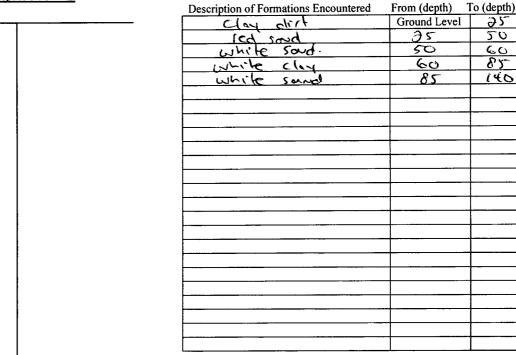

Description of formations encountered must be provided for all

wells and boreholes, unless specifically exempted by regulations

If more than one screen, show location of each on sketch

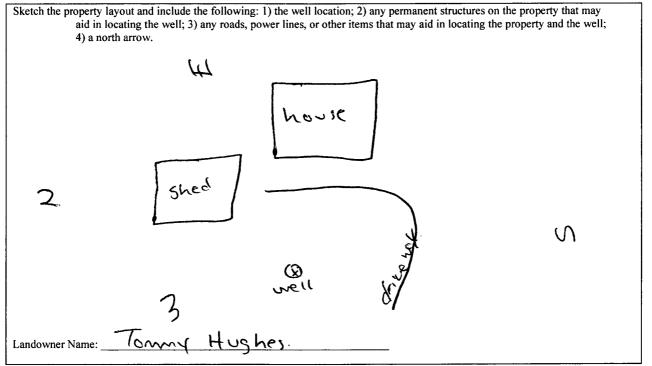

Form: OLWR-SWR-1A (04/08)

I certify that the well/borehole was drilled, constructed, and completed in accordance with all applicable requirements of the Mississippi Department of Environmental Quality and the Mississippi Department of Health regulations, if applicable, and state

laws Jano w. Marine CEIVED Janes W. Mr. 0-600 6-26-08 Print Name of Responsible Licensee and License No. Date

JUN 3 1 2008

SY: OLWR

STATE WELL REPORT			
County: Marshall	Part 2 Pump Installer's Completion Report	For Office Use Only:	
Permit #:	Mississippi Department of Environmental Quality Office of Land and Water Resources	Aquifer:	
Driller: Jours w. Moson	P.O. Box 2309 Jackson, MS 39225	Well # H- 334	
Date completed: <u>5-31-08</u> Copy information from block on Part 1	(601)961-5210 (601)961-5228 (fax)	Elevation:	
	J		

WELL DEDOD

OT

Well Owner Information	Well Logation				
report must be attached and both parts filed with the Department at the above address within 30 days of well completion.					
This part of the report must be completed by a licensed water well of	contractor or a licensed pump installer. A copy of Part 1 of the				

well Owner Information	Well Location
Owner Name: Tonny Hugher	Latitude: 34.49.600 Longitude: 89.42.204
Mailing Address: Lot 29 Stric Eland rd forms.	Method of Lat/Long (check one): Conventional Survey,
	USGS quad, Hand-held GPS 1/2, Survey-grade GPS
Byholia MJ 3P611 City State Zip Code	JE 1/ NW 1/4 Sec 14 T 35 R 5W
	Distance Direction Nearest Town
Telephone No. (901) $(413 - 168)$	Miles Show of UNICCSONS

Pump Type Circle one		Power Type Circle one			
Air Lift	Jet	Submersible	Diesel Engine	Gasoline Engine	Natural Gas
Bucket	Piston	Turbine	Electric Motor	Hand	Tractor PTO
Centrifugal	Rotary	Flowing Well	Windmill	Other (specify):	
Other (specify):			Horse Power Rating	of Motor: 3/4	
Date Pump Installed:	5-31-0	83	Setting Depth:	100	_feet
Rated Pump Capacity:	(0)	Gallons Per Minute	Number of Stages:	8	

Pump Test Data	Method of Measuring Water Level
Date Well Tested: 5-31-08	Circle one
Static Water Level (A): 60 Feet Below Land Surface	Air Line Electric Measuring Line Steel Tape Other (specify): <u>String Line (gift t</u>
Pumping Water Level (B):Feet Below Land Surface	
Drawdown [(B) – (A)]:Feet Below Land Surface	For flowing well, measured shut in head:feet
Test Pumping Rate: 10 Gallons Per Minute	Well yielded GPM with a drawdown of
Duration of Pump Test (minimum 4 hours): $\underline{\partial 4}$ hours	feet after hours of pumping

I HEREBY CERTIFY that the above statements are true to the best of	of my knowledge.	
Jones W. Mason 0-670	Gen w-M	RECEIVED
Print Name of Pump Installer and License No. (if applicable)	Signature of Pump Installer	
	Form: C	DLWR-541-13 (0-2088

BY OLWR