

State Well Report

Part 1

Mississippi Department of Environmental Quality
Office of Land and Water Resources

P.O. Box 2309
Jackson, MS 39226

For Office Use Only

Aquifer: _____
Well #: H-342
L.S. Elevation: _____
E-Long #: _____

County: MAHALL
Permit #: _____
Driller: BOB SMITH
Date drilling complet: 1-22-09

State Law requires that this report be prepared by the driller in detail and filed with the Department within 30 days of completion of drilling of the well.

Well Owner Information	Well Location
Owner Name: <u>SANDRA TILLEY</u>	Latitude: _____ "Longitude: _____"
Mailing Address: <u>P.O. Box 725</u>	Method of Lat/Long (circle one): Conventional Survey, USGS quad, Hand-held GPS, Survey-grade GPS
<u>BYHRIA, MS. 38611</u>	<u>1/4 1/4 Sec 23 Twn 135 Rng 15W</u>
City State Zip Code	Distance Direction Nearest Town
Telephone No. <u>901 848-9099</u>	<u>1 Miles N/W of WATSON</u>

Well Data

Purpose of Well (circle one) Home Industrial Public Supply Irrigation Fish Culture Other _____

Date well drilling started: 1-22-09 Date well drilling completed: 1-22-09

If flowing, method of flow regulation: Valve _____ Other (describe) _____

Static Water Level: 30 feet above or below (circle one) land surface Date measured: 1-22-08

Method of Measurement (circle one) steel tape electric tape air line other: LINE+WEIGHT

Hole Depth: 95 Well depth: 95 Well grouted to a depth of 10 feet

Type of grout: (circle one) Cement Bentonite Mix

Casing length: 85 feet Casing diameter: 4 inches Type of casing: PVC

Screen length: 10 feet Screen diameter: 4 inches Type of screen: PVC

Screen slot size: 13 THOUS inches Setting depth: From 85 feet to 95 feet

Type of completion (circle all applicable):
Gravel packed Underreamed Telescoped Open hole Natural Development
Other (describe): WASHED SAND

Top of lap pipe or reduction casing: _____ feet. If telescoped or more than one screen, describe on back

Logs run (circle one): No log run Electric Gamma Ray Density Sonic Neutron Other: _____

Name of organization running log(s): _____

I certify that the well drilled, constructed, and completed in accordance with all applicable requirements of the Mississippi Department of Environmental Quality and/or the Mississippi Department of Health regulations and state laws.

Bob Smith 0645
Print name of Water Contractor and License No.

[Signature] RECEIVED
Signature of Water Well Contractor

FEB 19 2009

BY: OLWR

State Well Report

Part 2

Pump Installer's Completion Report

Mississippi Department of Environmental Quality

Office of Land and Water Resources

P.O. Box 2309

Jackson, MS 39225

For Office Use Only
Aquifer: _____
Well #: <u>H-342</u>
Elevation: _____

County: <u>MAISSALE</u>
Permit #: _____
Driller: <u>BOB SMITH</u>
Date completed: <u>1-22-09</u>

This report be prepared by the pump installer in detail and filled will the Department within 30 days of completion of drilling of the well.

Well Owner Information	Well Location
Owner Name: <u>SANDRA TILLEY</u>	Latitude: _____ Longitude: _____
Mailing Address: <u>P.O. Box 725</u>	Method of Lat/Long (circle one): Conventional Survey
<u>BYHAMIA MS 38611</u>	USGS quad, Hand-held GPS, survey grade GPS
City State Zip Code	<u>1/4 1/4 Sec 23 Twn T35 Rng R5W</u>
Telephone No. <u>(901) 848-9099</u>	Distance Direction Nearest Town
	<u>1 miles N/W of WATSON</u>

Pump Type Circle one	Power Type Circle one
Air lift Jet <input checked="" type="radio"/> <u>Submersible</u>	Diesel Engine Gasoline Engine Natural Gas
Bucket Piston Turbine	<input checked="" type="radio"/> <u>Electric Motor</u> Hand Tractor PTO
Centrifugal Rotary Flowing Well	Windmill Other(specify): _____
Other (specify): _____	Horse Power Rating of Motor: <u>1</u>
Date Pump Installed: <u>1-22-09</u>	Setting Depth: <u>60</u> feet
Rated Pump Capacity: <u>8</u> gallons per min	Number of Stages: <u>9</u>


Pump Test Data	Method of Measuring Water Level circle one
Date Well Tested: <u>1-22-09</u>	Air Line Electric Measuring Line Steel Tape
Static Water Level(A): <u>30</u> feet below Land Surface	Other(specify): <u>LINE + WEIGHT</u>
Rumping Water Level(B): _____ feet below Land Surface	For flowing well, measured shut in head: _____ feet
Drawdown[(B)-(A)]: _____ feet below Land Surface	Well yielded <u>12</u> GPM with a drawdown of
Test Pumping Rate: <u>12</u> gallons per Minute	_____ feet after _____ hours of pumping
Duration of Pump Test(minimum 4 hours): _____ hrs	

I HEREBY CERTIFY that the above statements are true to the best of my knowledge.	
<u>BOB SMITH 0645</u>	
Print Name of Pump Installer and License No.	Signature of Pump Installer

RECEIVED
FEB 19 2009
BY: OLWR

H-342

Ground Level

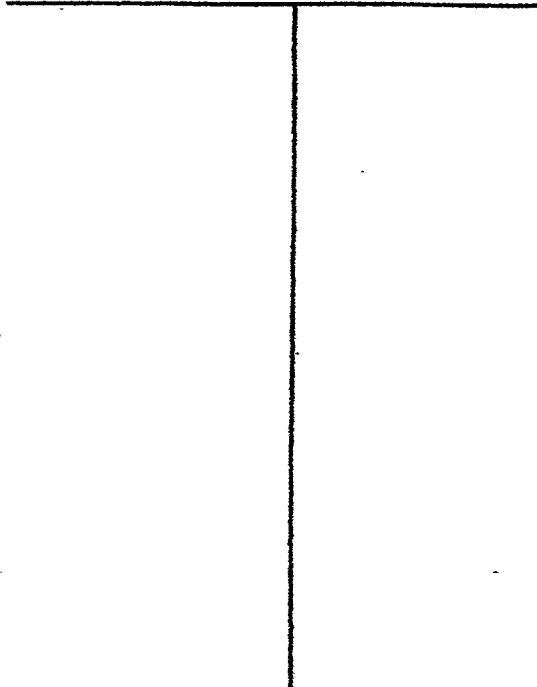


Description of Formations Encountered	From	To
TOP SOIL	0	5
BROWN CLAY	5	18
WHITE CLAY	18	40
WHITE SAND	40	95

If more than one screen, show location of each on sketch

Sketch the property layout and include the following: 1) the well location; 2) any permanent structures on the property that may aid in locating the well; 3) any roads, power lines, or other items that may aid in locating the property and the well; 4) indicate direction.

Landowner Name: SANDRA TILLEY


 Signature of Water Well Contractor

RECEIVED
 FEB 19 2009
 BY: OLWR